

NOTES

- ALL STORMWATER PIPES ARE RCP CLASS 2 U.N.O.

AS CONSTRUCTED CERTIFICATION

(Company's representative Name) (Signature)

(Date) (RPEQ)

Being a duly representative of- (Company Name)

Hereby certify that


- The information contained in this drawing / document is in compliance with approved drawings and design supplied under the terms of the contract.
- This represents an accurate "As constructed" record of works carried out and accept responsibility for the information contained in this drawing / document.

REGISTERED CADASTRAL SURVEYOR (QLD) CERTIFICATION

LandPartners Pty Ltd hereby certify that the vertical and horizontal locations and dimensions shown on this plan are a true and correct record and were located by survey.

R. G. Andrew 4118 20/05/2026
 Authorised Delegate Rego No. Date
 LandPartners Pty Ltd
 Registered Qld Surveyor Corporation

COORDINATE DATUM NOTE:
 HORIZONTAL COORDINATES (E,N) SUPPLIED ARE MAPPING GRID OF AUSTRALIA (MGA), ZONE 56 BASED ON THE UNIVERSAL TRANSVERSE MERCATOR PROJECTION AND THE GEOCENTRIC DATUM OF AUSTRALIA 2020.

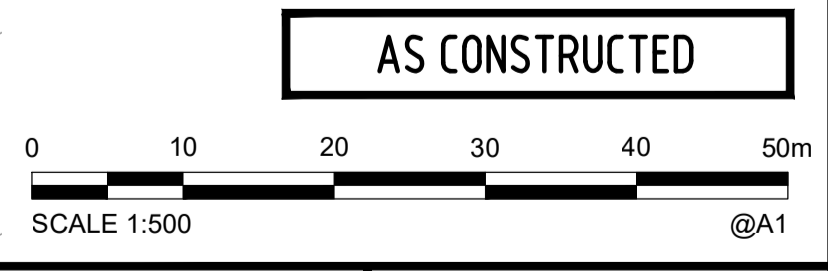


A1	1	20/05/2026	INITIAL ISSUE	BB	VO	JV
	INDEX	DATE	REVISIONS	DRAWN	CHECKED	PASSED

MNG LANDPARTNERS

Brisbane Office
 Level 1
 18 Little Cribb Street
 Milton QLD 4064
 p: (07) 3842 1000
 e: brisbane@mnglandpartners.com.au
 w: www.landpartners.com.au

Perth | Brisbane | Melbourne | Sydney | Broome | South West WA

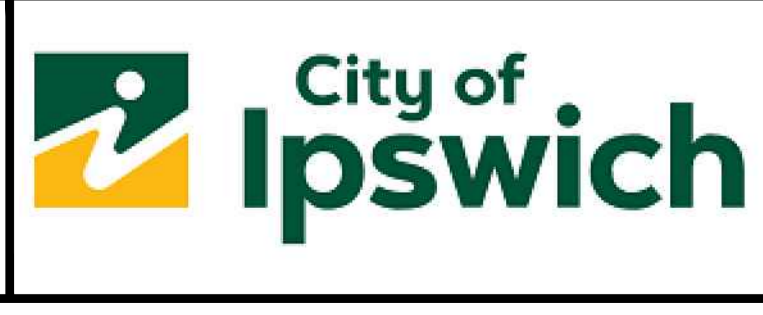

IPSWICH CITY COUNCIL

AMORY AT RIPLEY STAGE 1A
 RIPLEY ESTATE DEVELOPMENT PTY LTD
 AS CONSTRUCTED STORMWATER

SCALE 1:500
 SHEET 1 OF 1 SHEETS
 DRAWING NO.
 BRSS8354-01A-66-1