

LEGEND

●	(FH) FIRE HYDRANT
⌵	(VS) STOP VALVE
□	(TB) TAPPING BAND
×	(WM) WATER METER (SEQ 20Ø)
⌒	END CAP
⌒	TEE
<	(RE) REDUCER
○	BEND
—	DICL WATER MAIN CROSSING
- - - - -	CONDUIT/CROSSING
—	EXISTING WATER

NOTES

- ALL FIRE HYDRANTS ARE Ø100 SPRING U.N.O.
- ALL WATER RETICULATION PE-100 WATER MAINS ARE PN16 U.N.O.
- ALL WATER RETICULATION DICL WATER MAINS ARE PN35 U.N.O.

ENGINEER'S CERTIFICATION


I, _____, hereby certify that the as-constructed details shown on this drawing are a true and accurate record of the construction works in compliance with the contract documents, approved drawings and approved design.

RPEQ (signature) RPEQ No. _____ Date: _____


REGISTERED CADASTRAL SURVEYOR (QLD) CERTIFICATION

LandPartners Pty Ltd, hereby certify that the vertical and horizontal locations and dimensions shown on this plan are a true and accurate record and were located by survey.

C. Walter
Authorised Delegate Reg. Surveyor No. 4118 Date: 15/06/2026
LandPartners Pty Ltd
Registered QLD Surveyor Corporation

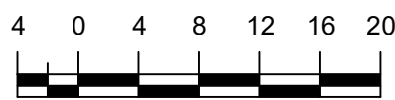

SCALE OF METRES
1 : 500 FULL SIZE A1 SHEET

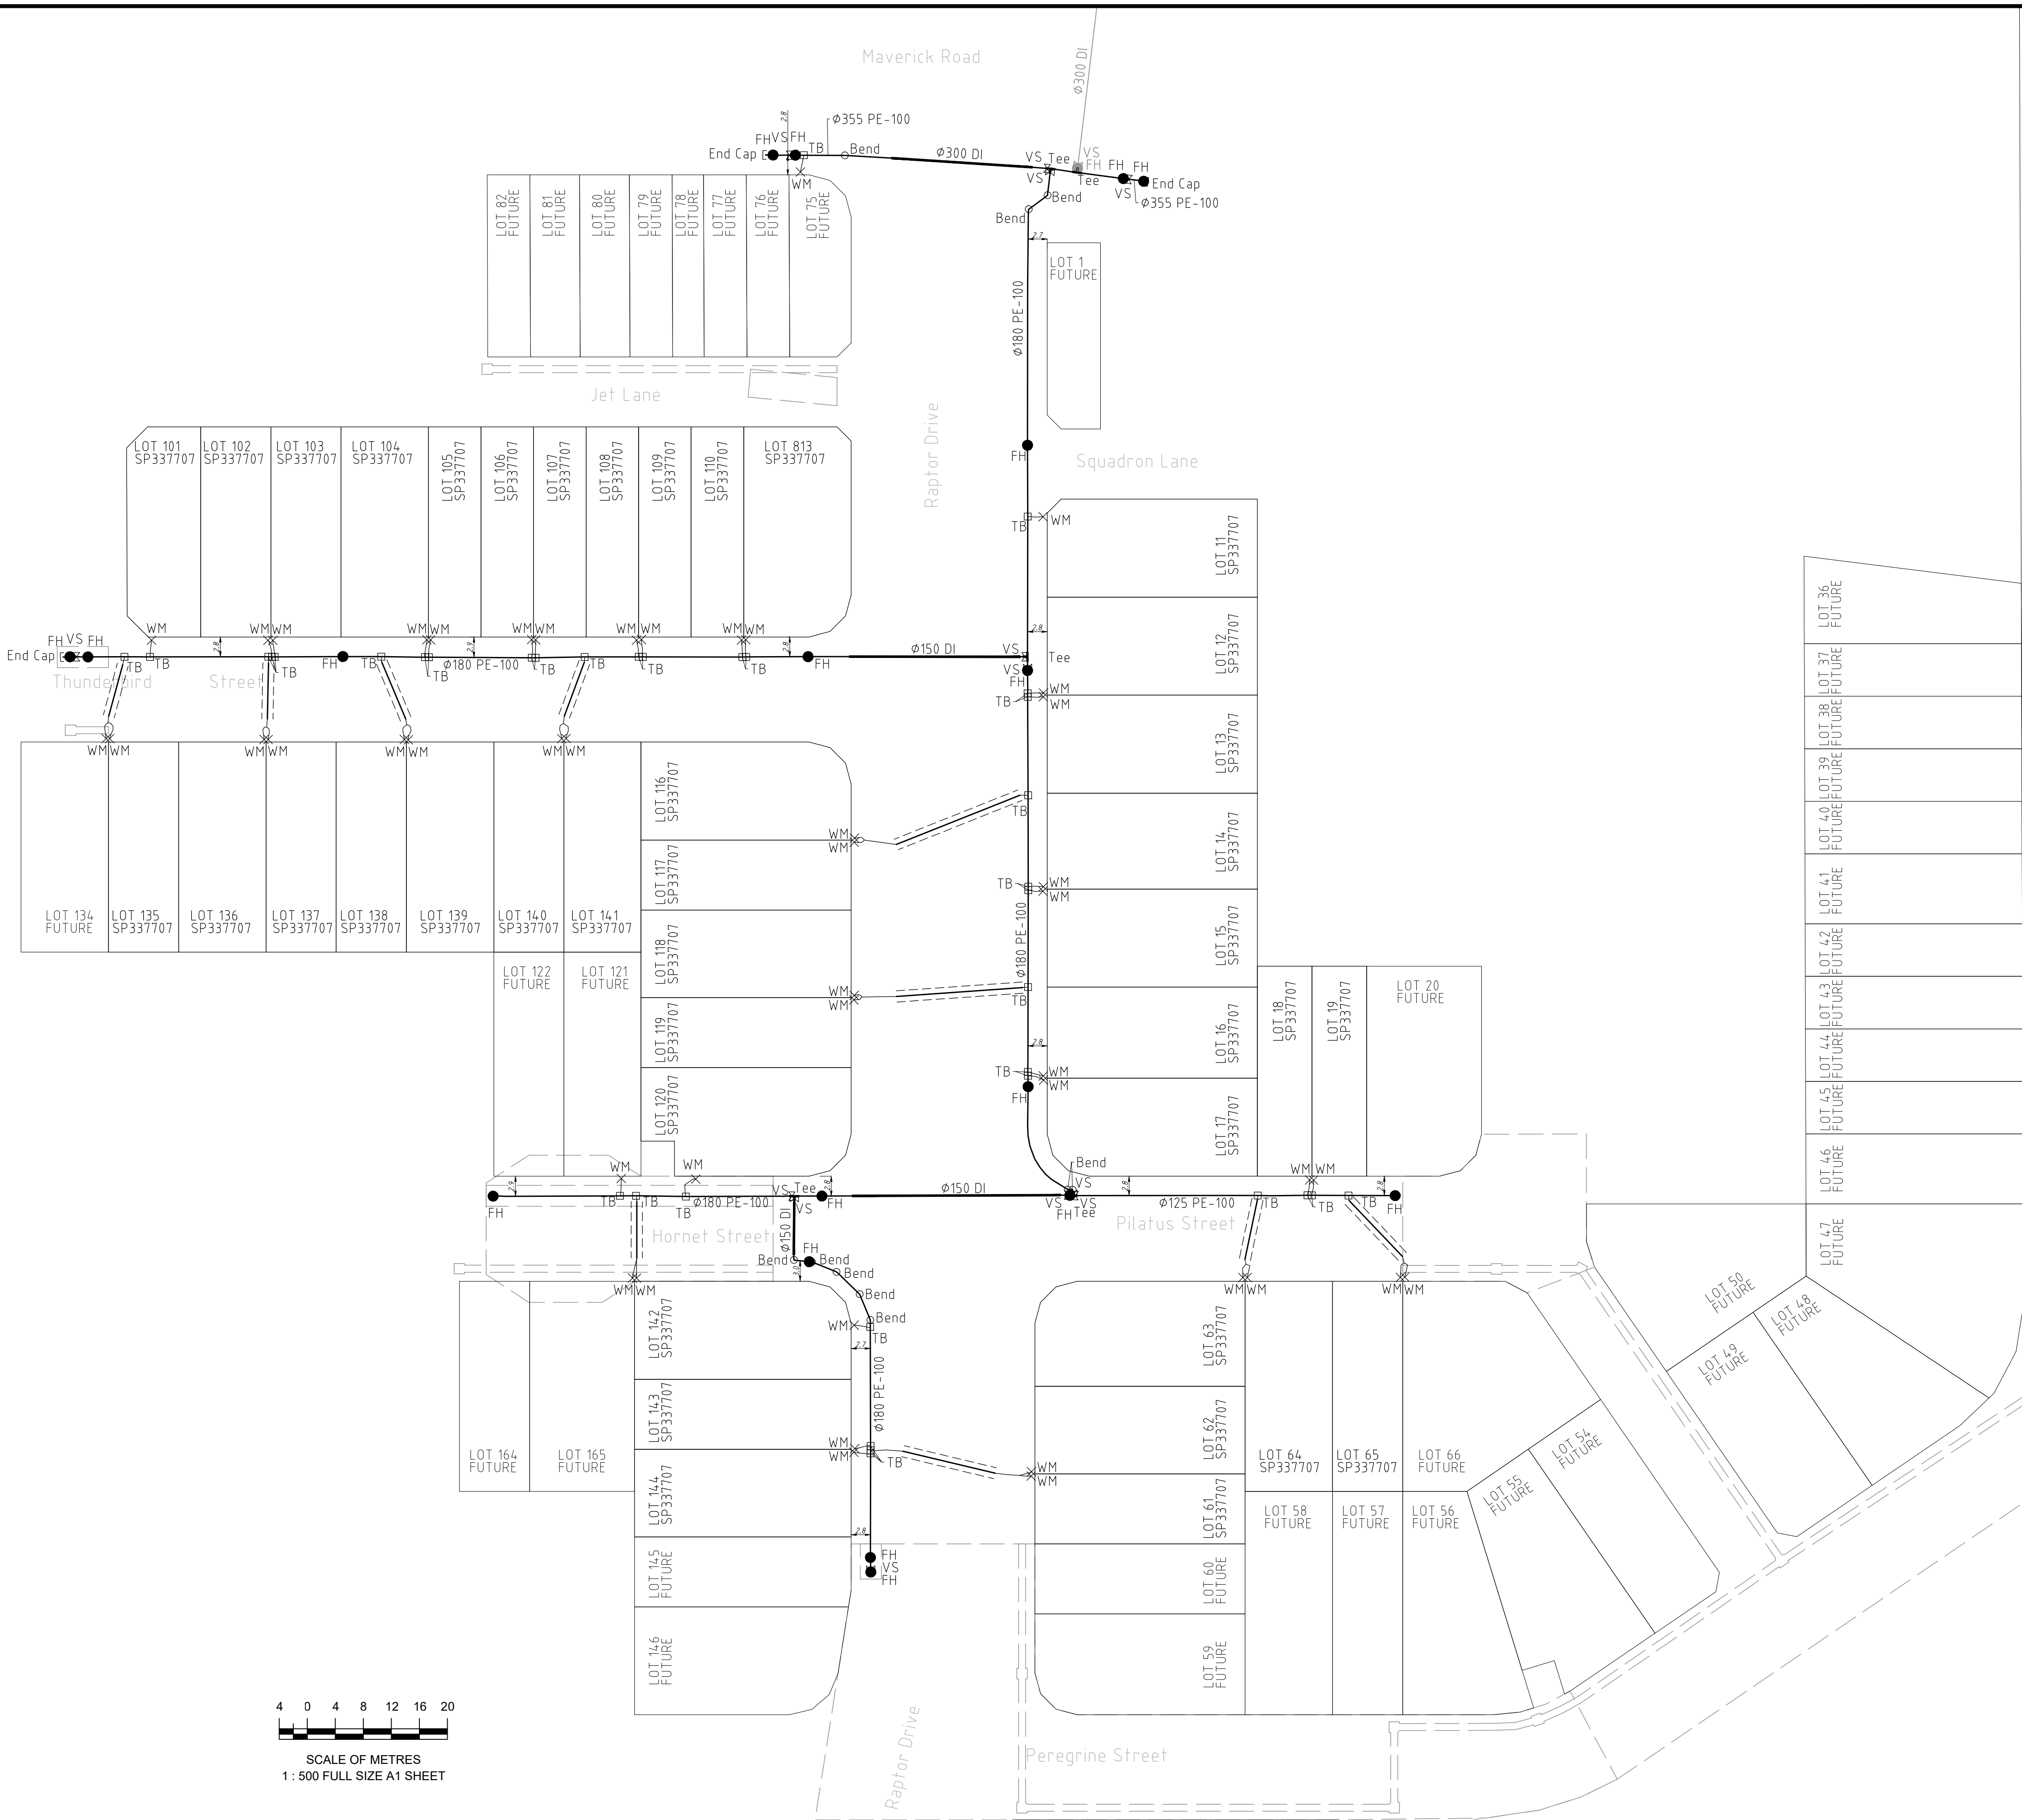

A1

REV NO	DATE	REVISION PURPOSE / DESCRIPTION	DRAWN	RPEQ	RPEQ No	INITIALS	DATE
2	15/06/2026	LOT 120 WM MOVED				BB	15/06/2026
1	08/06/2026	INITIAL ISSUE	BB			JV	15/06/2026



Brisbane Office
Level 1
18 Little Cribb Street
Milton QLD 4064
p: (07) 3842 1000
e: brisbane@mnglandpartners.com.au
w: www.landpartners.com.au
Perth | Brisbane | Melbourne | Sydney | Broome | South West WA

Ripley Estate Development Pty Ltd

AMORY AT RIPLEY STAGE 01A
24-PNT-72894

AS CONSTRUCTED
WATER

DRAWING STATUS
AS CONSTRUCTED

SHEET 1 OF 1 SHEETS

DRAWING NO.

BRSS8354-01A-70

REV.

2