


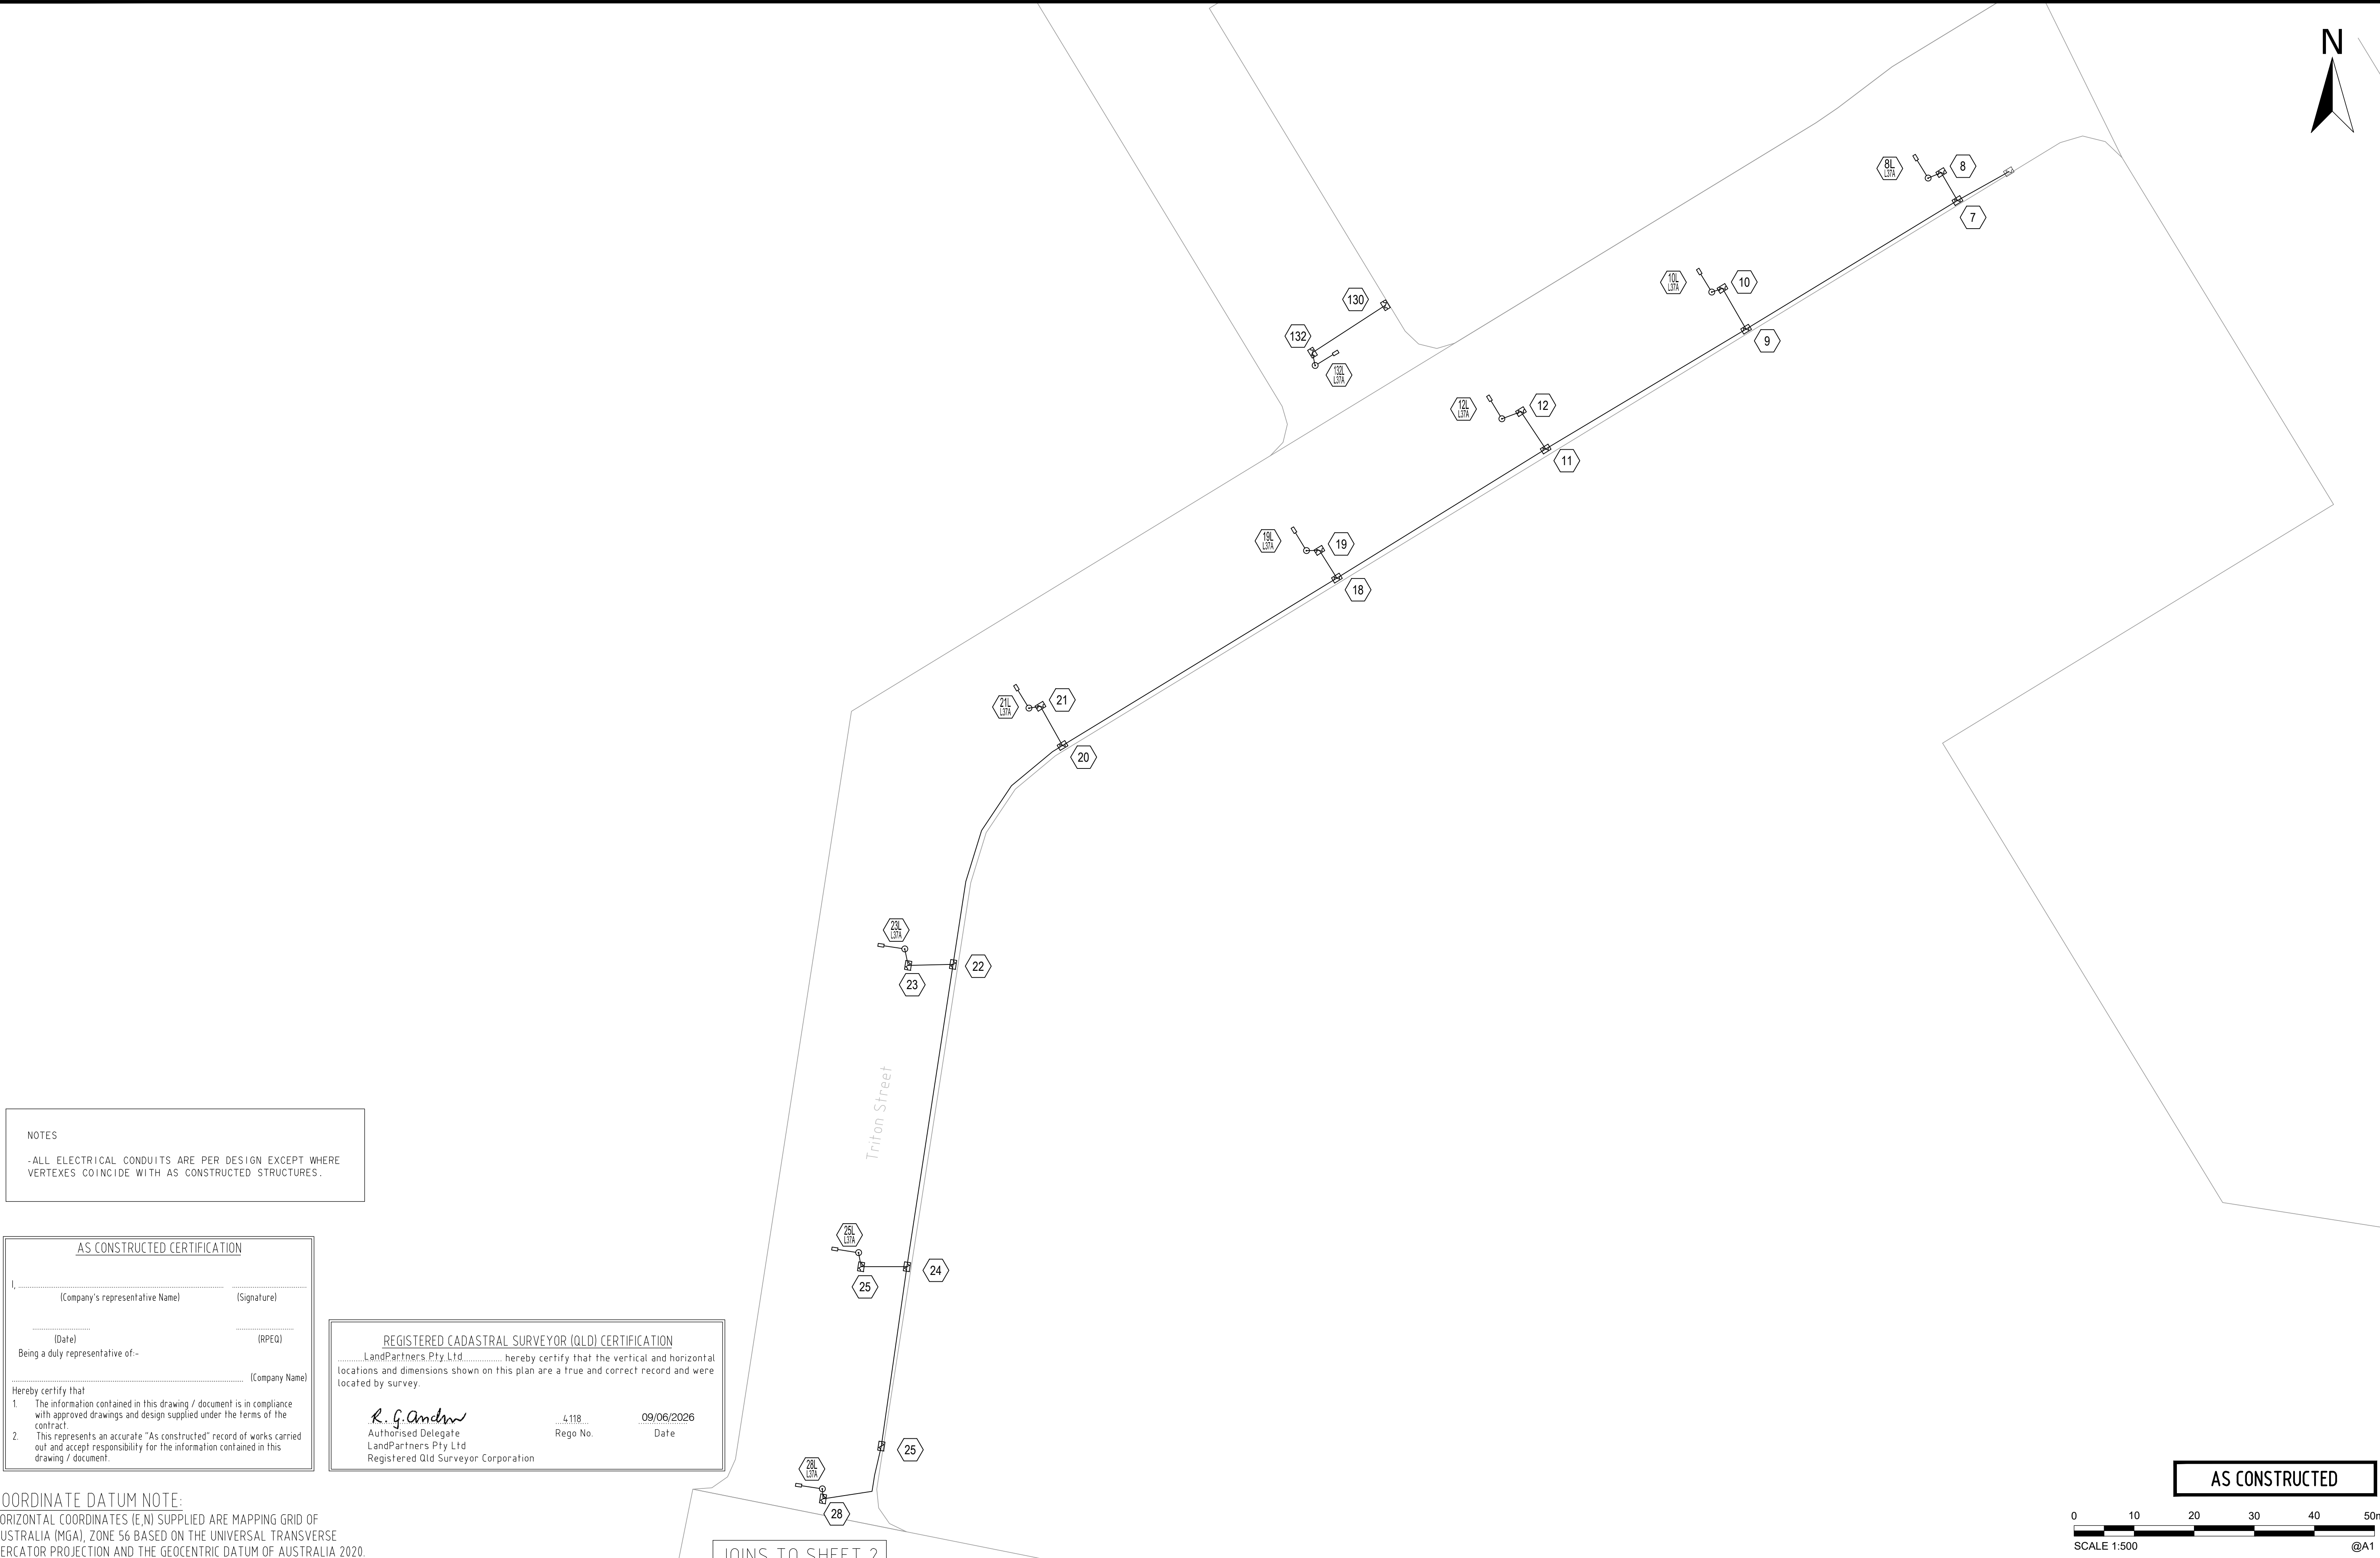

-ALL ELECTRICAL CONDUITS ARE PER DESIGN EXCEPT WHERE  
VERTECES COINCIDE WITH AS CONSTRUCTED STRUCTURES.

| AS CONSTRUCTED CERTIFICATION                                                                                                                                                                                                                                                                                                |                                                                                                   |
|-----------------------------------------------------------------------------------------------------------------------------------------------------------------------------------------------------------------------------------------------------------------------------------------------------------------------------|---------------------------------------------------------------------------------------------------|
| I, .....<br><div style="text-align: center; border-top: 1px solid black; margin-top: 10px;">(Company's representative Name)</div>                                                                                                                                                                                           | <div style="text-align: center; border-top: 1px solid black; margin-top: 10px;">(Signature)</div> |
| (Date) .....<br>Being a duly representative of:- .....                                                                                                                                                                                                                                                                      | (RPEQ) .....                                                                                      |
| Hereby certify that ..... (Company Name)                                                                                                                                                                                                                                                                                    |                                                                                                   |
| 1. The information contained in this drawing / document is in compliance with approved drawings and design supplied under the terms of the contract.<br><br>2. This represents an accurate "As constructed" record of works carried out and accept responsibility for the information contained in this drawing / document. |                                                                                                   |

REGISTERED CADASTRAL SURVEYOR (QLD) CERTIFICATION

LandPartners Pty Ltd \_\_\_\_\_ hereby certify that the vertical and horizontal locations and dimensions shown on this plan are a true and correct record and were located by survey.

*R. G. Anderson* \_\_\_\_\_ 4118 \_\_\_\_\_ 09/06/2026  
Authorised Delegate Rego No. Date  
LandPartners Pty Ltd  
Registered Qld Surveyor Corporation


JOINS TO SHEET 2

[illegible]







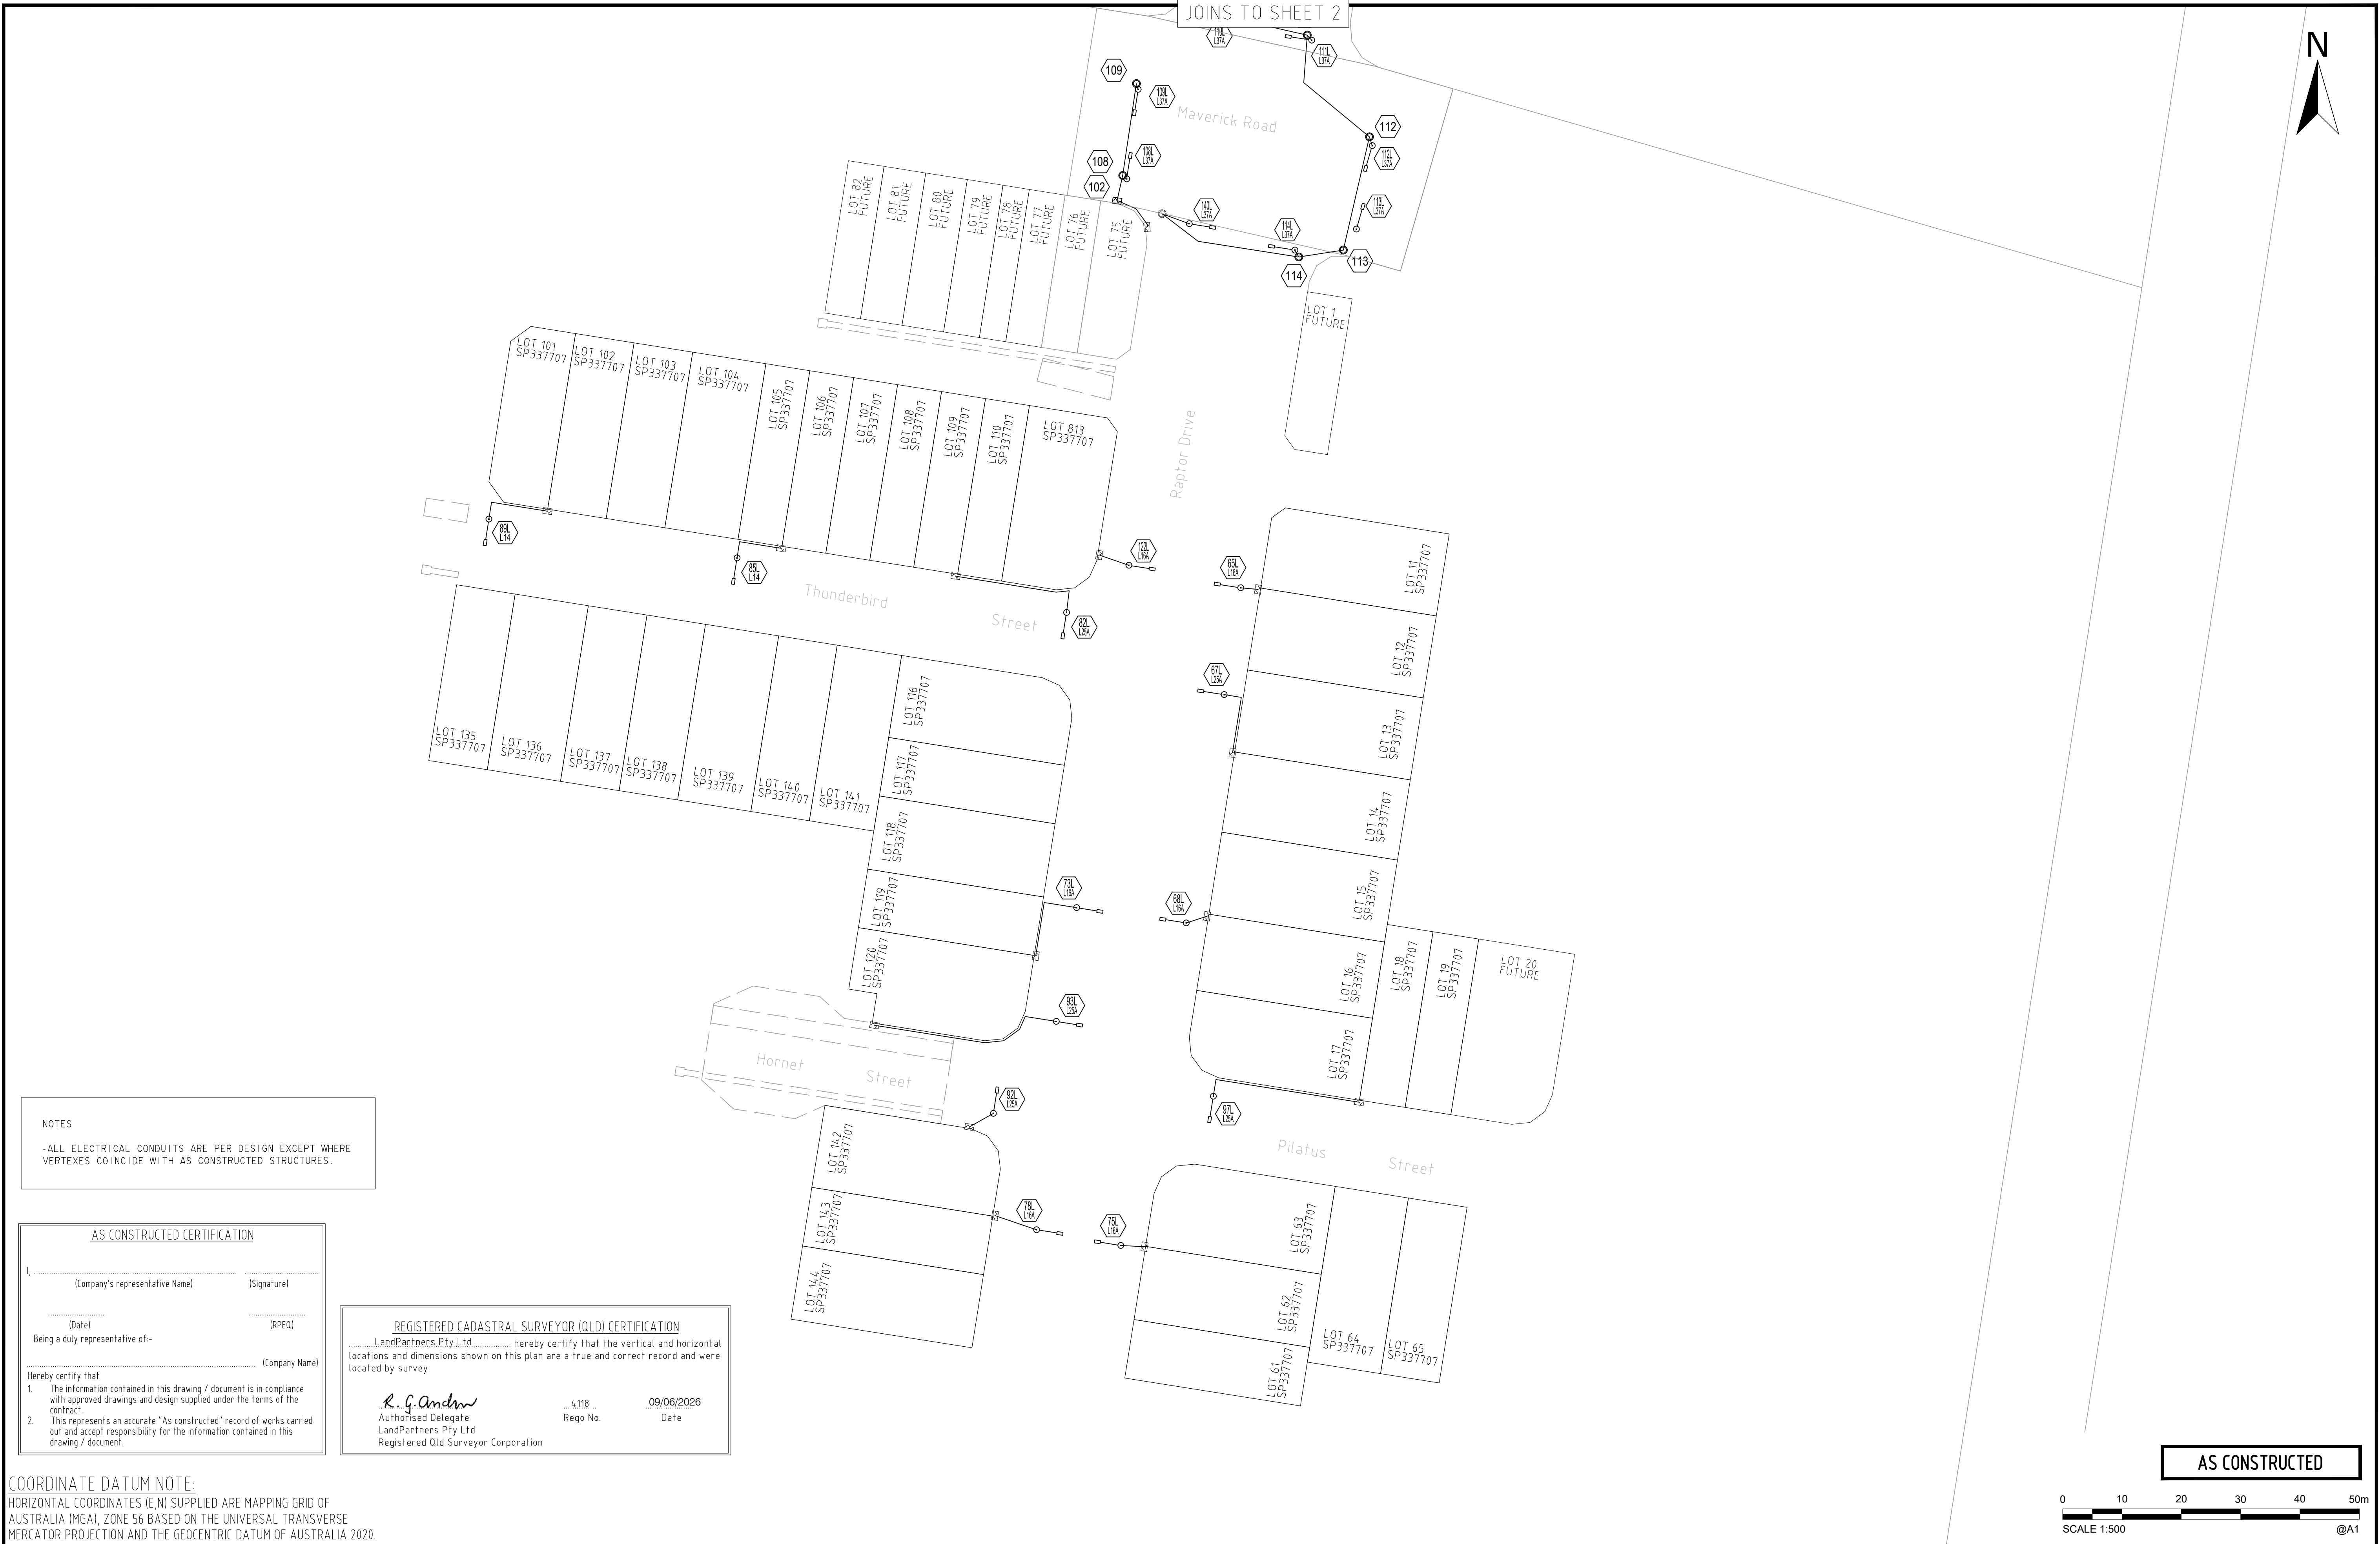

NOTES

-ALL ELECTRICAL CONDUITS ARE PER DESIGN EXCEPT WHERE VERTEXES COINCIDE WITH AS CONSTRUCTED STRUCTURES.

AS CONSTRUCTED CERTIFICATION

I, \_\_\_\_\_  
(Company's representative Name)

\_\_\_\_\_  
(Signature)

\_\_\_\_\_  
(Date)

\_\_\_\_\_  
(RPEQ)

Being a duly representative of:- \_\_\_\_\_  
(Company Name)

Hereby certify that

1. The information contained in this drawing / document is in compliance with approved drawings and design supplied under the terms of the contract.

2. This represents an accurate "As constructed" record of works carried out and accept responsibility for the information contained in this drawing / document.

REGISTERED CADASTRAL SURVEYOR (QLD) CERTIFICATION

LandPartners Pty Ltd \_\_\_\_\_ hereby certify that the vertical and horizontal locations and dimensions shown on this plan are a true and correct record and were located by survey.

R. G. Andrew  
Authorised Delegate  
LandPartners Pty Ltd  
Registered Qld Surveyor Corporation

4,118  
Rego No.

09/06/2026  
Date

COORDINATE DATUM NOTE:  
HORIZONTAL COORDINATES (E,N) SUPPLIED ARE MAPPING GRID OF AUSTRALIA (MGA), ZONE 56 BASED ON THE UNIVERSAL TRANSVERSE MERCATOR PROJECTION AND THE GEOCENTRIC DATUM OF AUSTRALIA 2020.

AS CONSTRUCTED

01020304050

SCALE 1:500

@A1