

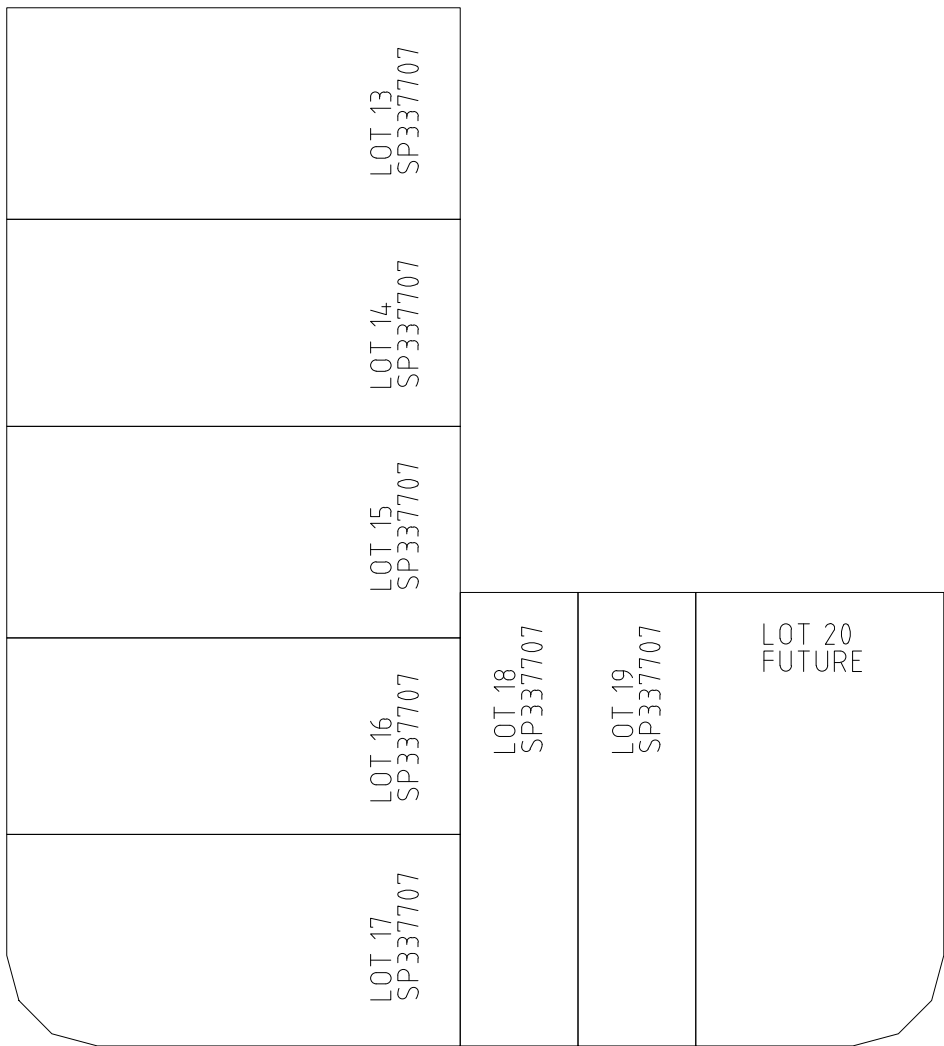
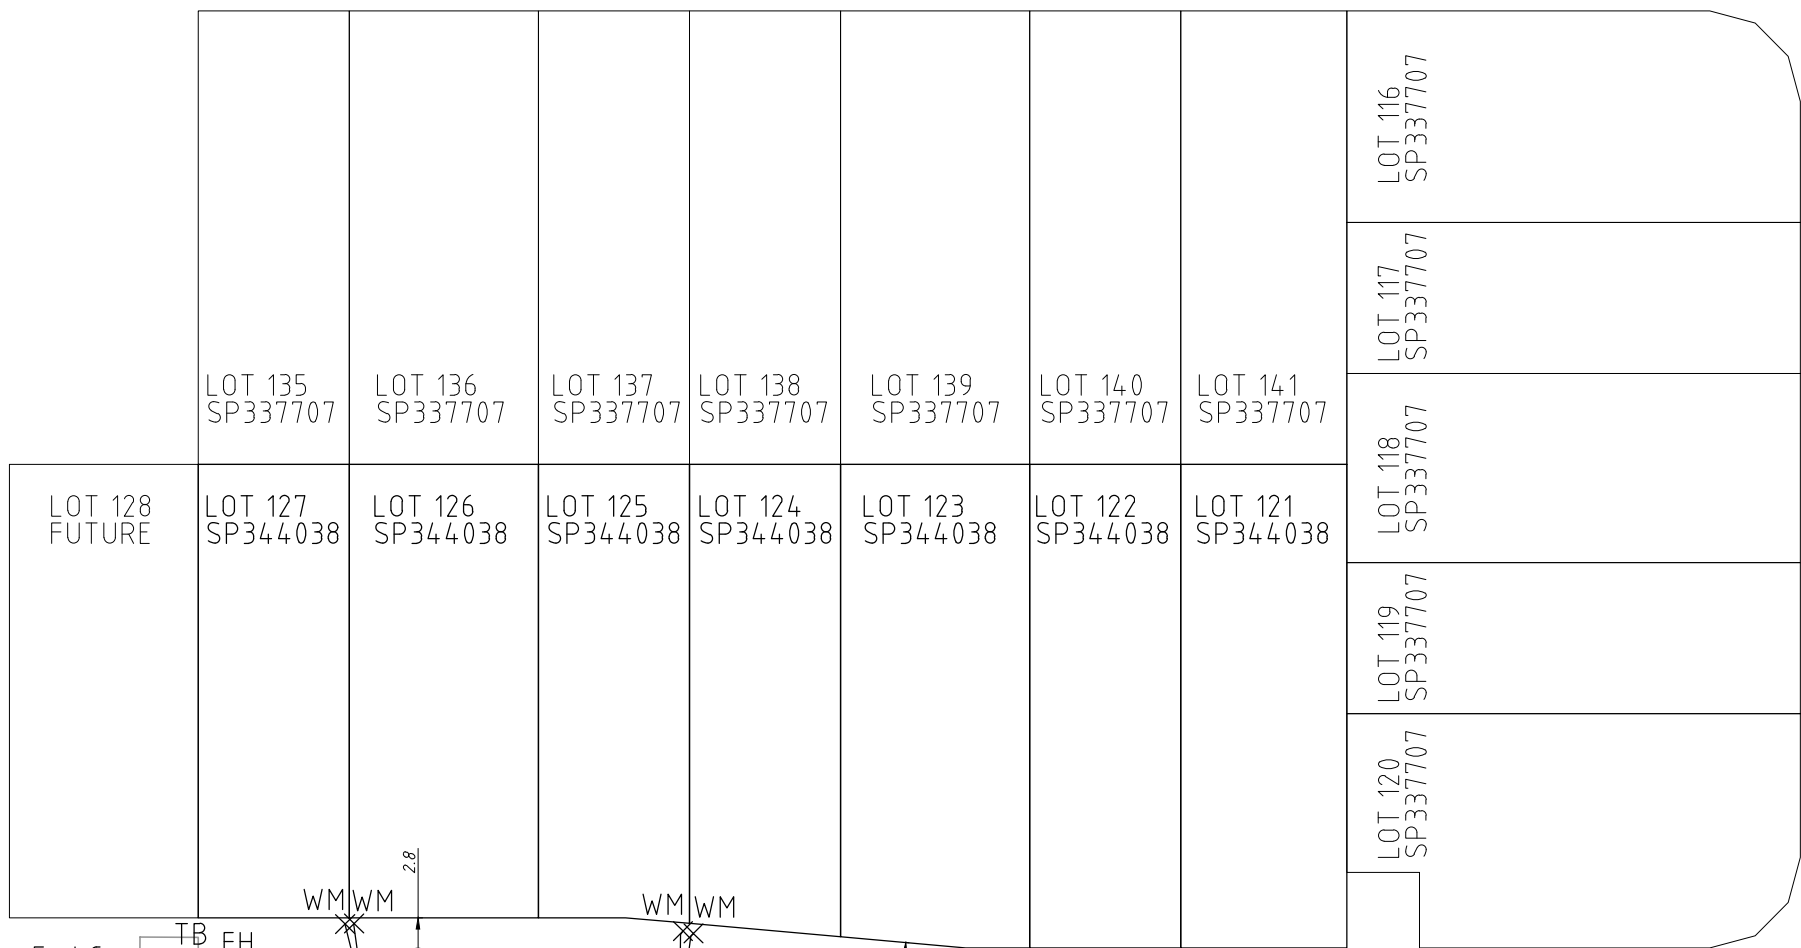
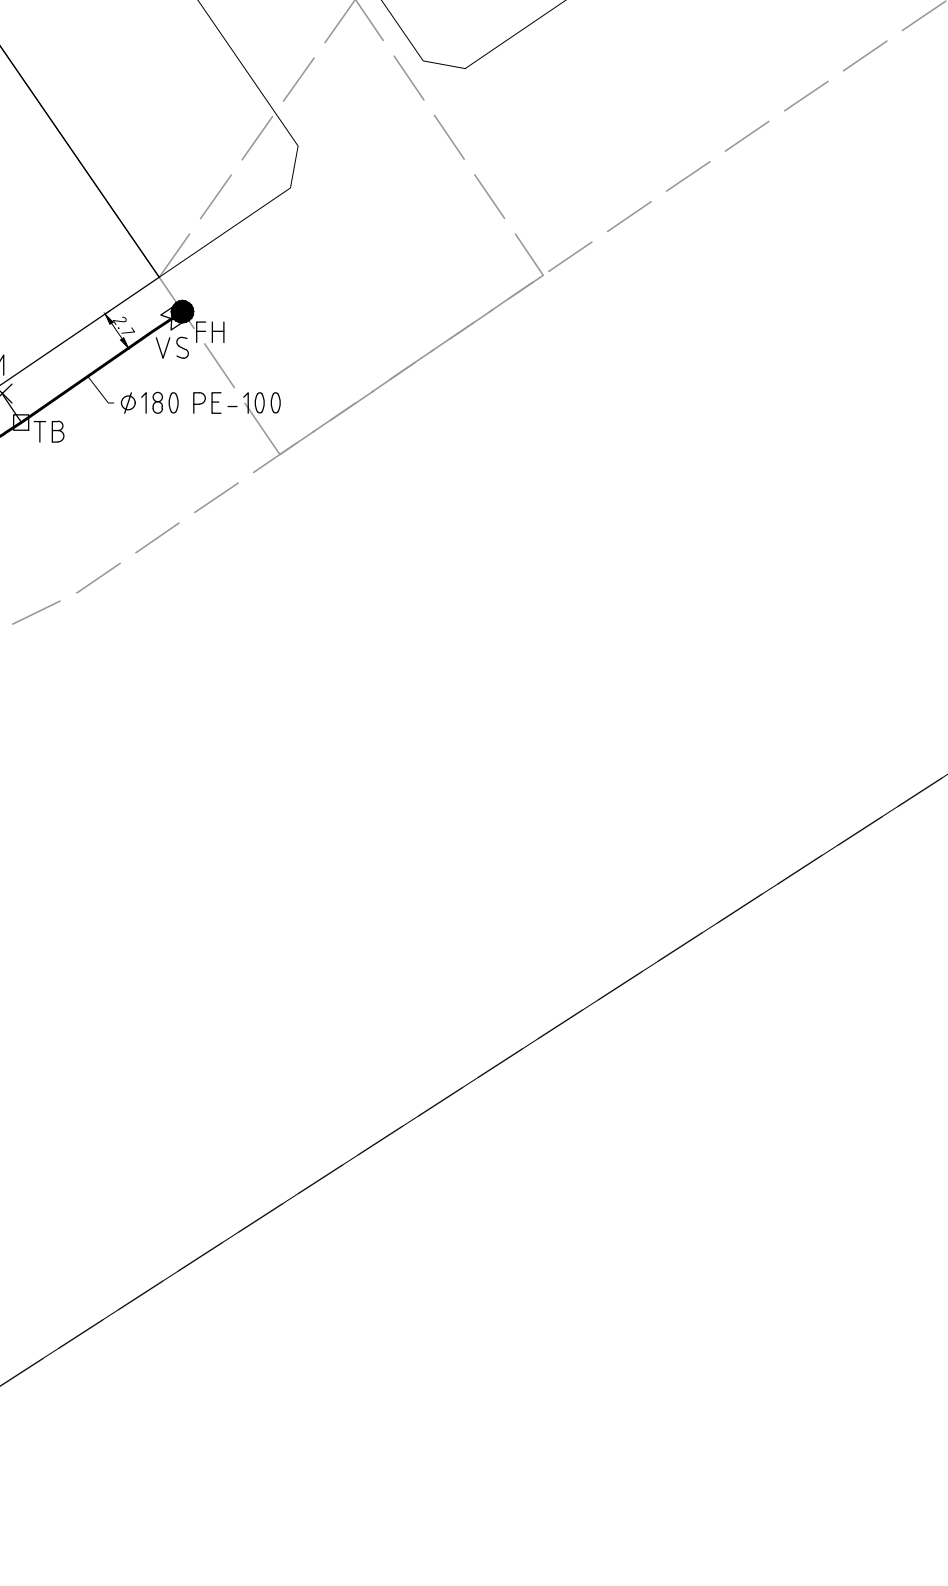
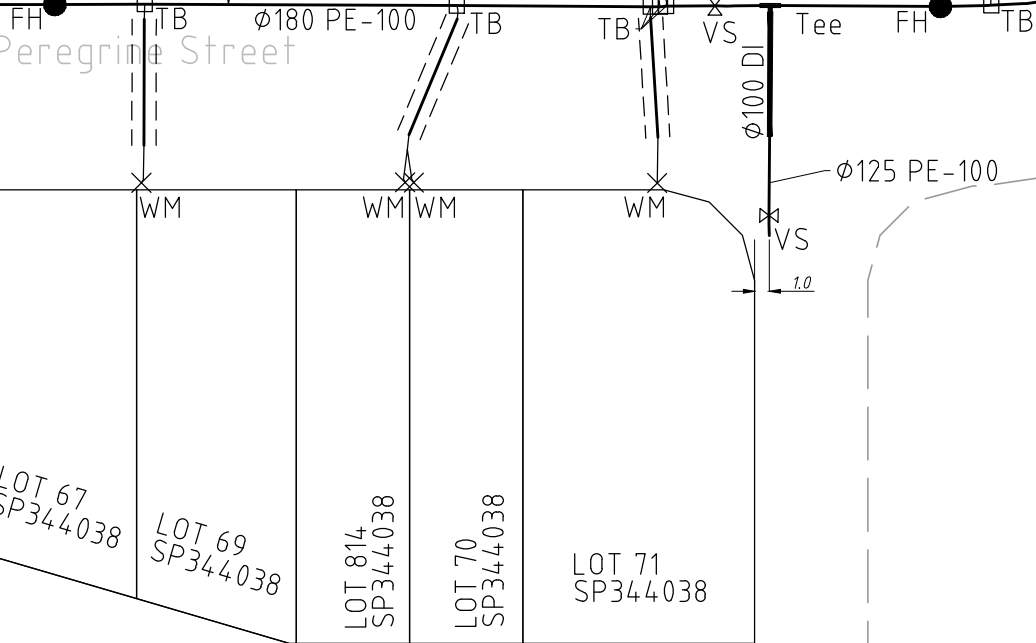
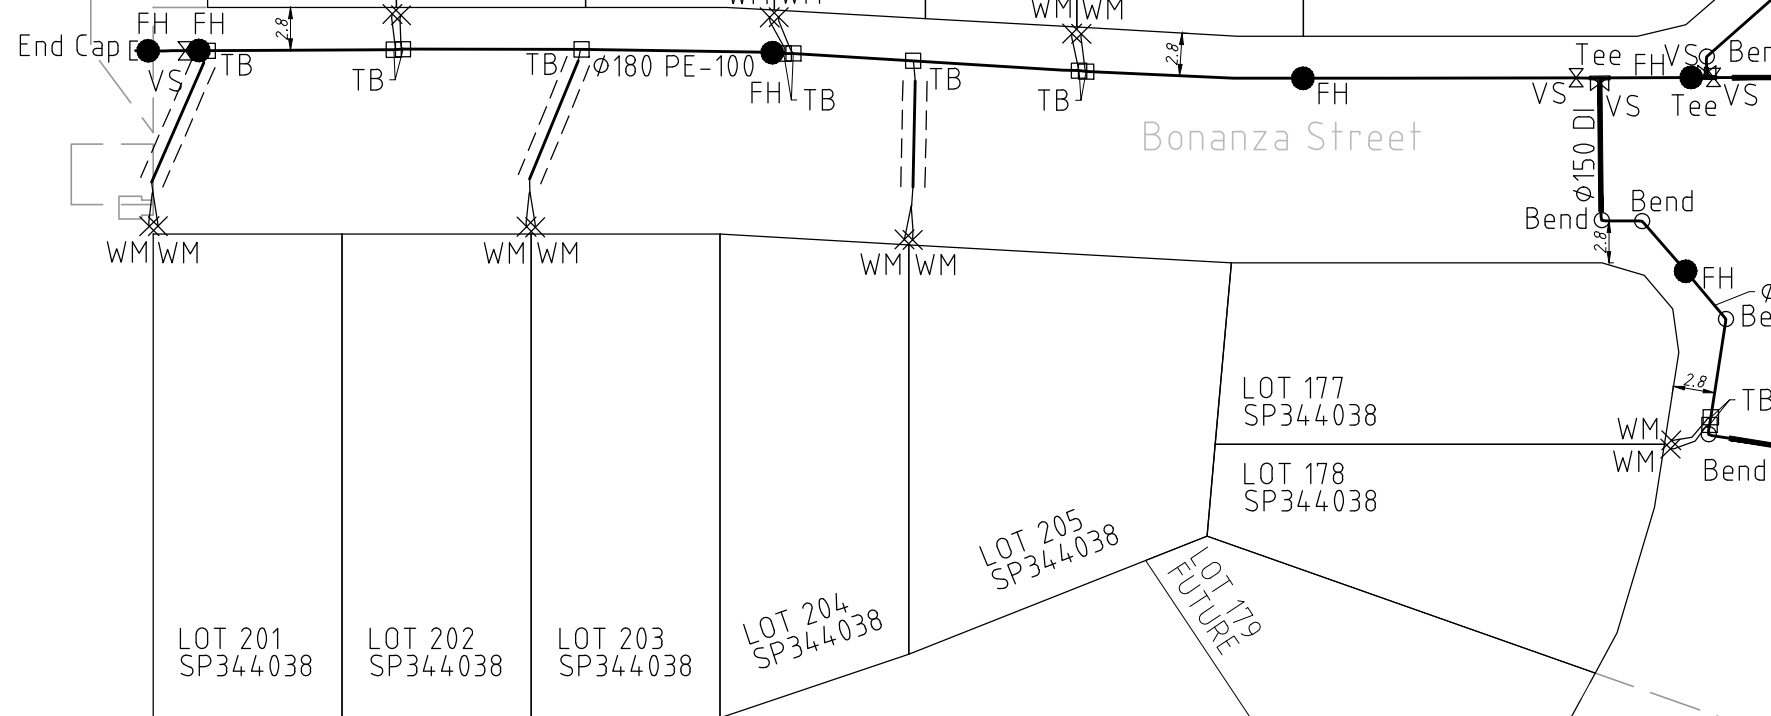
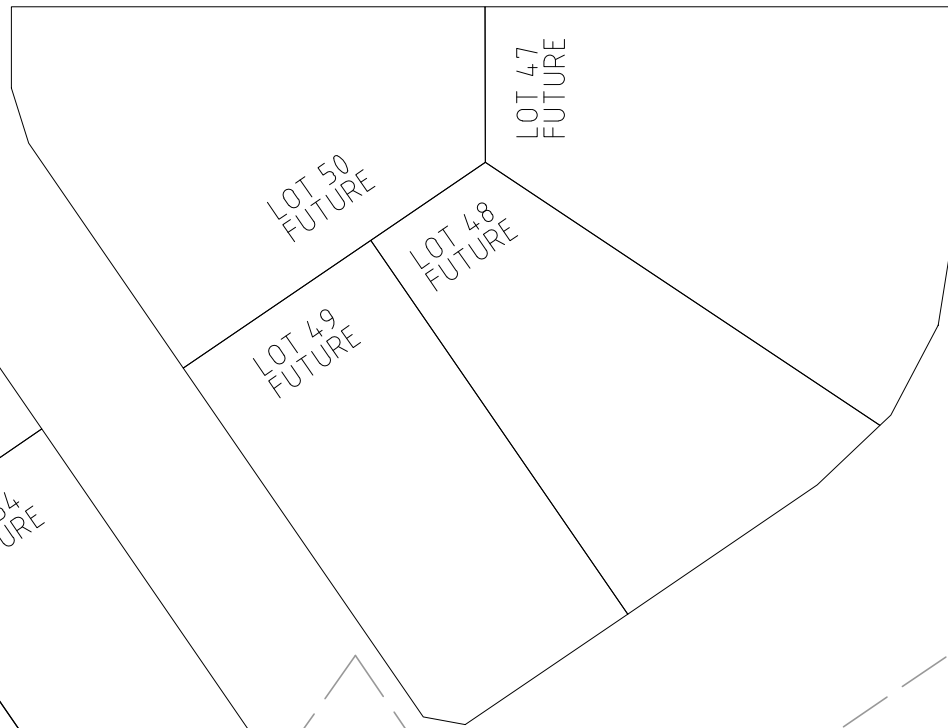


Thunderbird Street

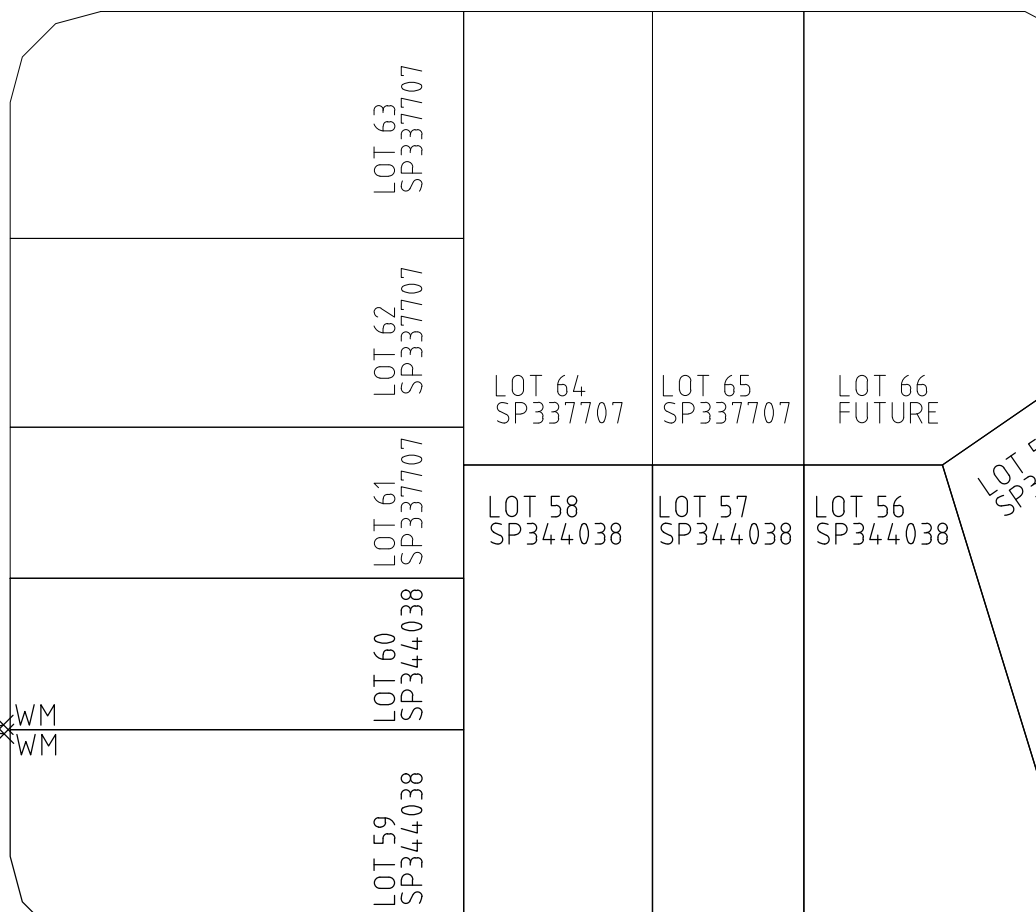

Hornet Street

Pilatus Street

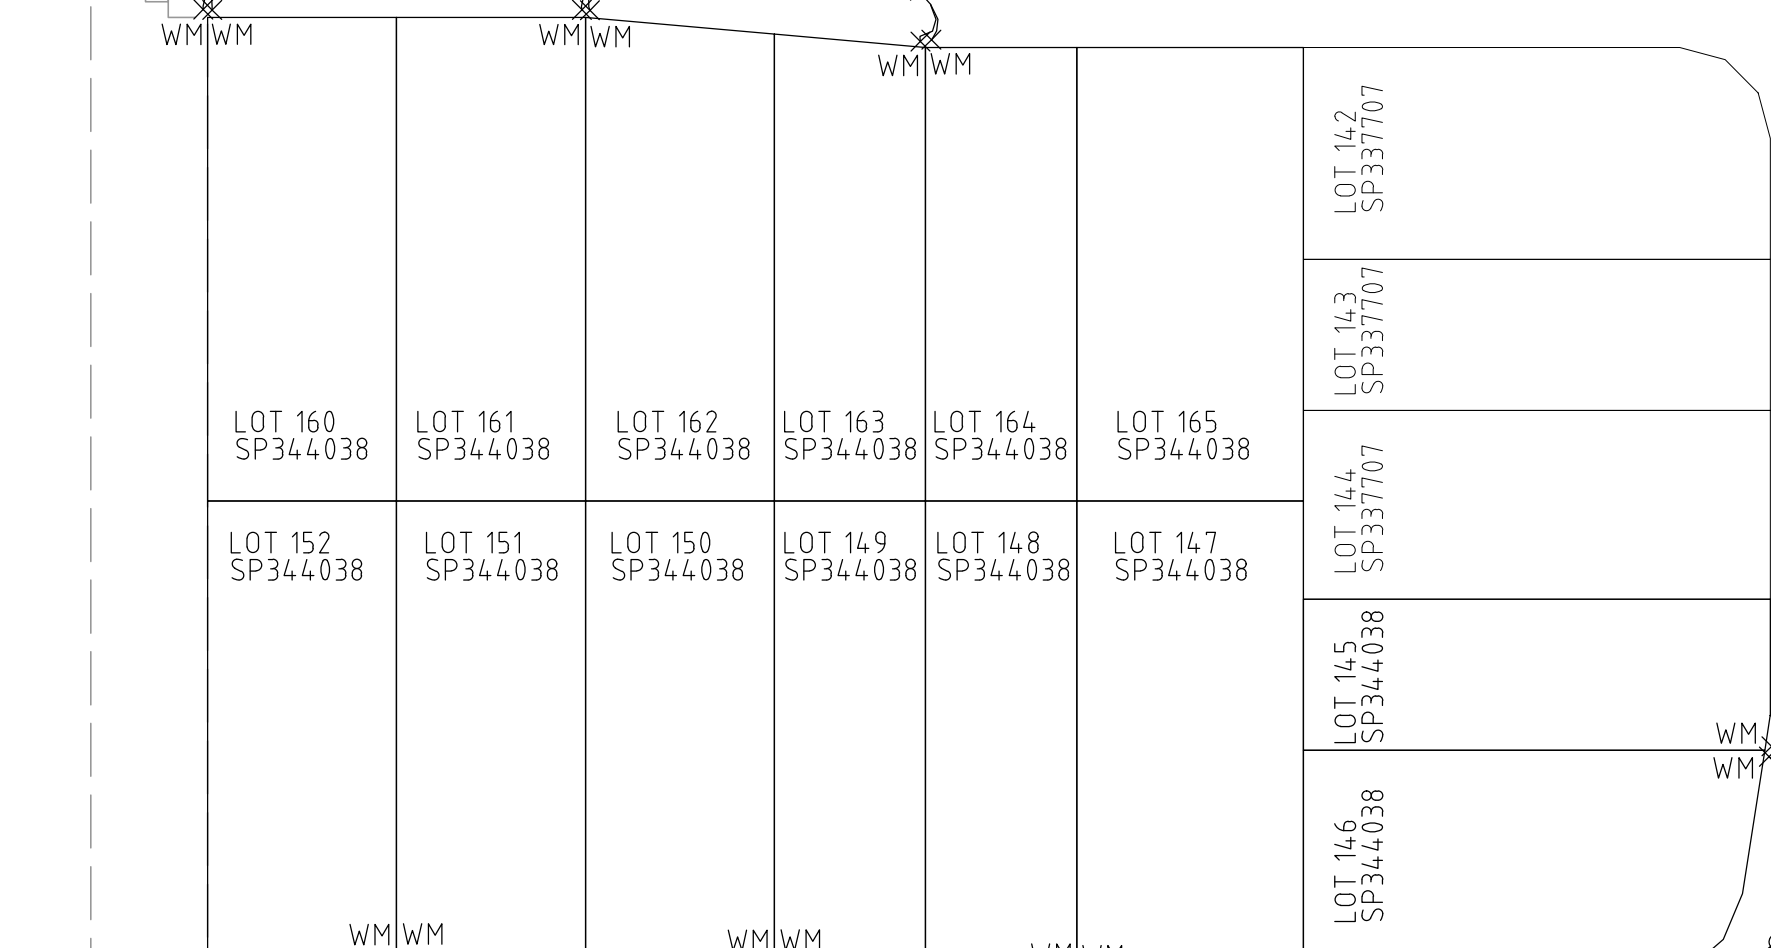

Peregrine Street

LEGEND

- (FH) FIRE HYDRANT
- ⊗ (VS) STOP VALVE
- (TB) TAPPING BAND
- × (WM) WATER METER (SEQ 20φ)
- ┘ END CAP
- ┘ TEE
- < (RE) REDUCER
- BEND
- DIWL WATER MAIN CROSSING
- - - - CONDUIT/CROSSING
- EXISTING WATER

NOTES

- ALL FIRE HYDRANTS ARE Ø100 SPRING U.N.O.
- ALL WATER RETICULATION PE-100 WATER MAINS ARE PN16 U.N.O.
- ALL WATER RETICULATION DIWL WATER MAINS ARE PN35 U.N.O.

ENGINEER'S CERTIFICATION

I, _____, hereby certify that the as-constructed details shown on this drawing are a true and accurate record of the construction works in compliance with the contract documents, approved drawings and approved design.

RPEQ (signature) RPEQ No. _____ Date: _____

REGISTERED CADASTRAL SURVEYOR (QLD) CERTIFICATION

LandPartners Pty Ltd, hereby certify that the vertical and horizontal locations and dimensions shown on this plan are a true and accurate record and were located by survey.

C. Walker
Authorised Delegate Reg. Surveyor No. 4118 Date: 15/06/2026
LandPartners Pty Ltd
Registered QLD Surveyor Corporation



SCALE OF METRES
1 : 500 FULL SIZE A1 SHEET

A1

REV NO	DATE	REVISION PURPOSE / DESCRIPTION	DRAWN	RPEQ	RPEQ No	INITIALS	DATE
2	15/06/2026	LOT 67 WM MOVED					
1	09/06/2026	INITIAL ISSUE	BB				



Brisbane Office
Level 1
18 Little Cribb Street
Milton QLD 4064
p: (07) 3842 1000
e: brisbane@mnglandpartners.com.au
w: www.landpartners.com.au
Perth | Brisbane | Melbourne | Sydney | Broome | South West WA

Ripley Estate Development Pty Ltd

AMORY AT RIPLEY STAGE 01B
24-PNT-74562

AS CONSTRUCTED
WATER

DRAWING STATUS	
AS CONSTRUCTED	
SHEET 1 OF 1 SHEETS	
DRAWING NO.	REV.
BRSS8354-01B-64	2