


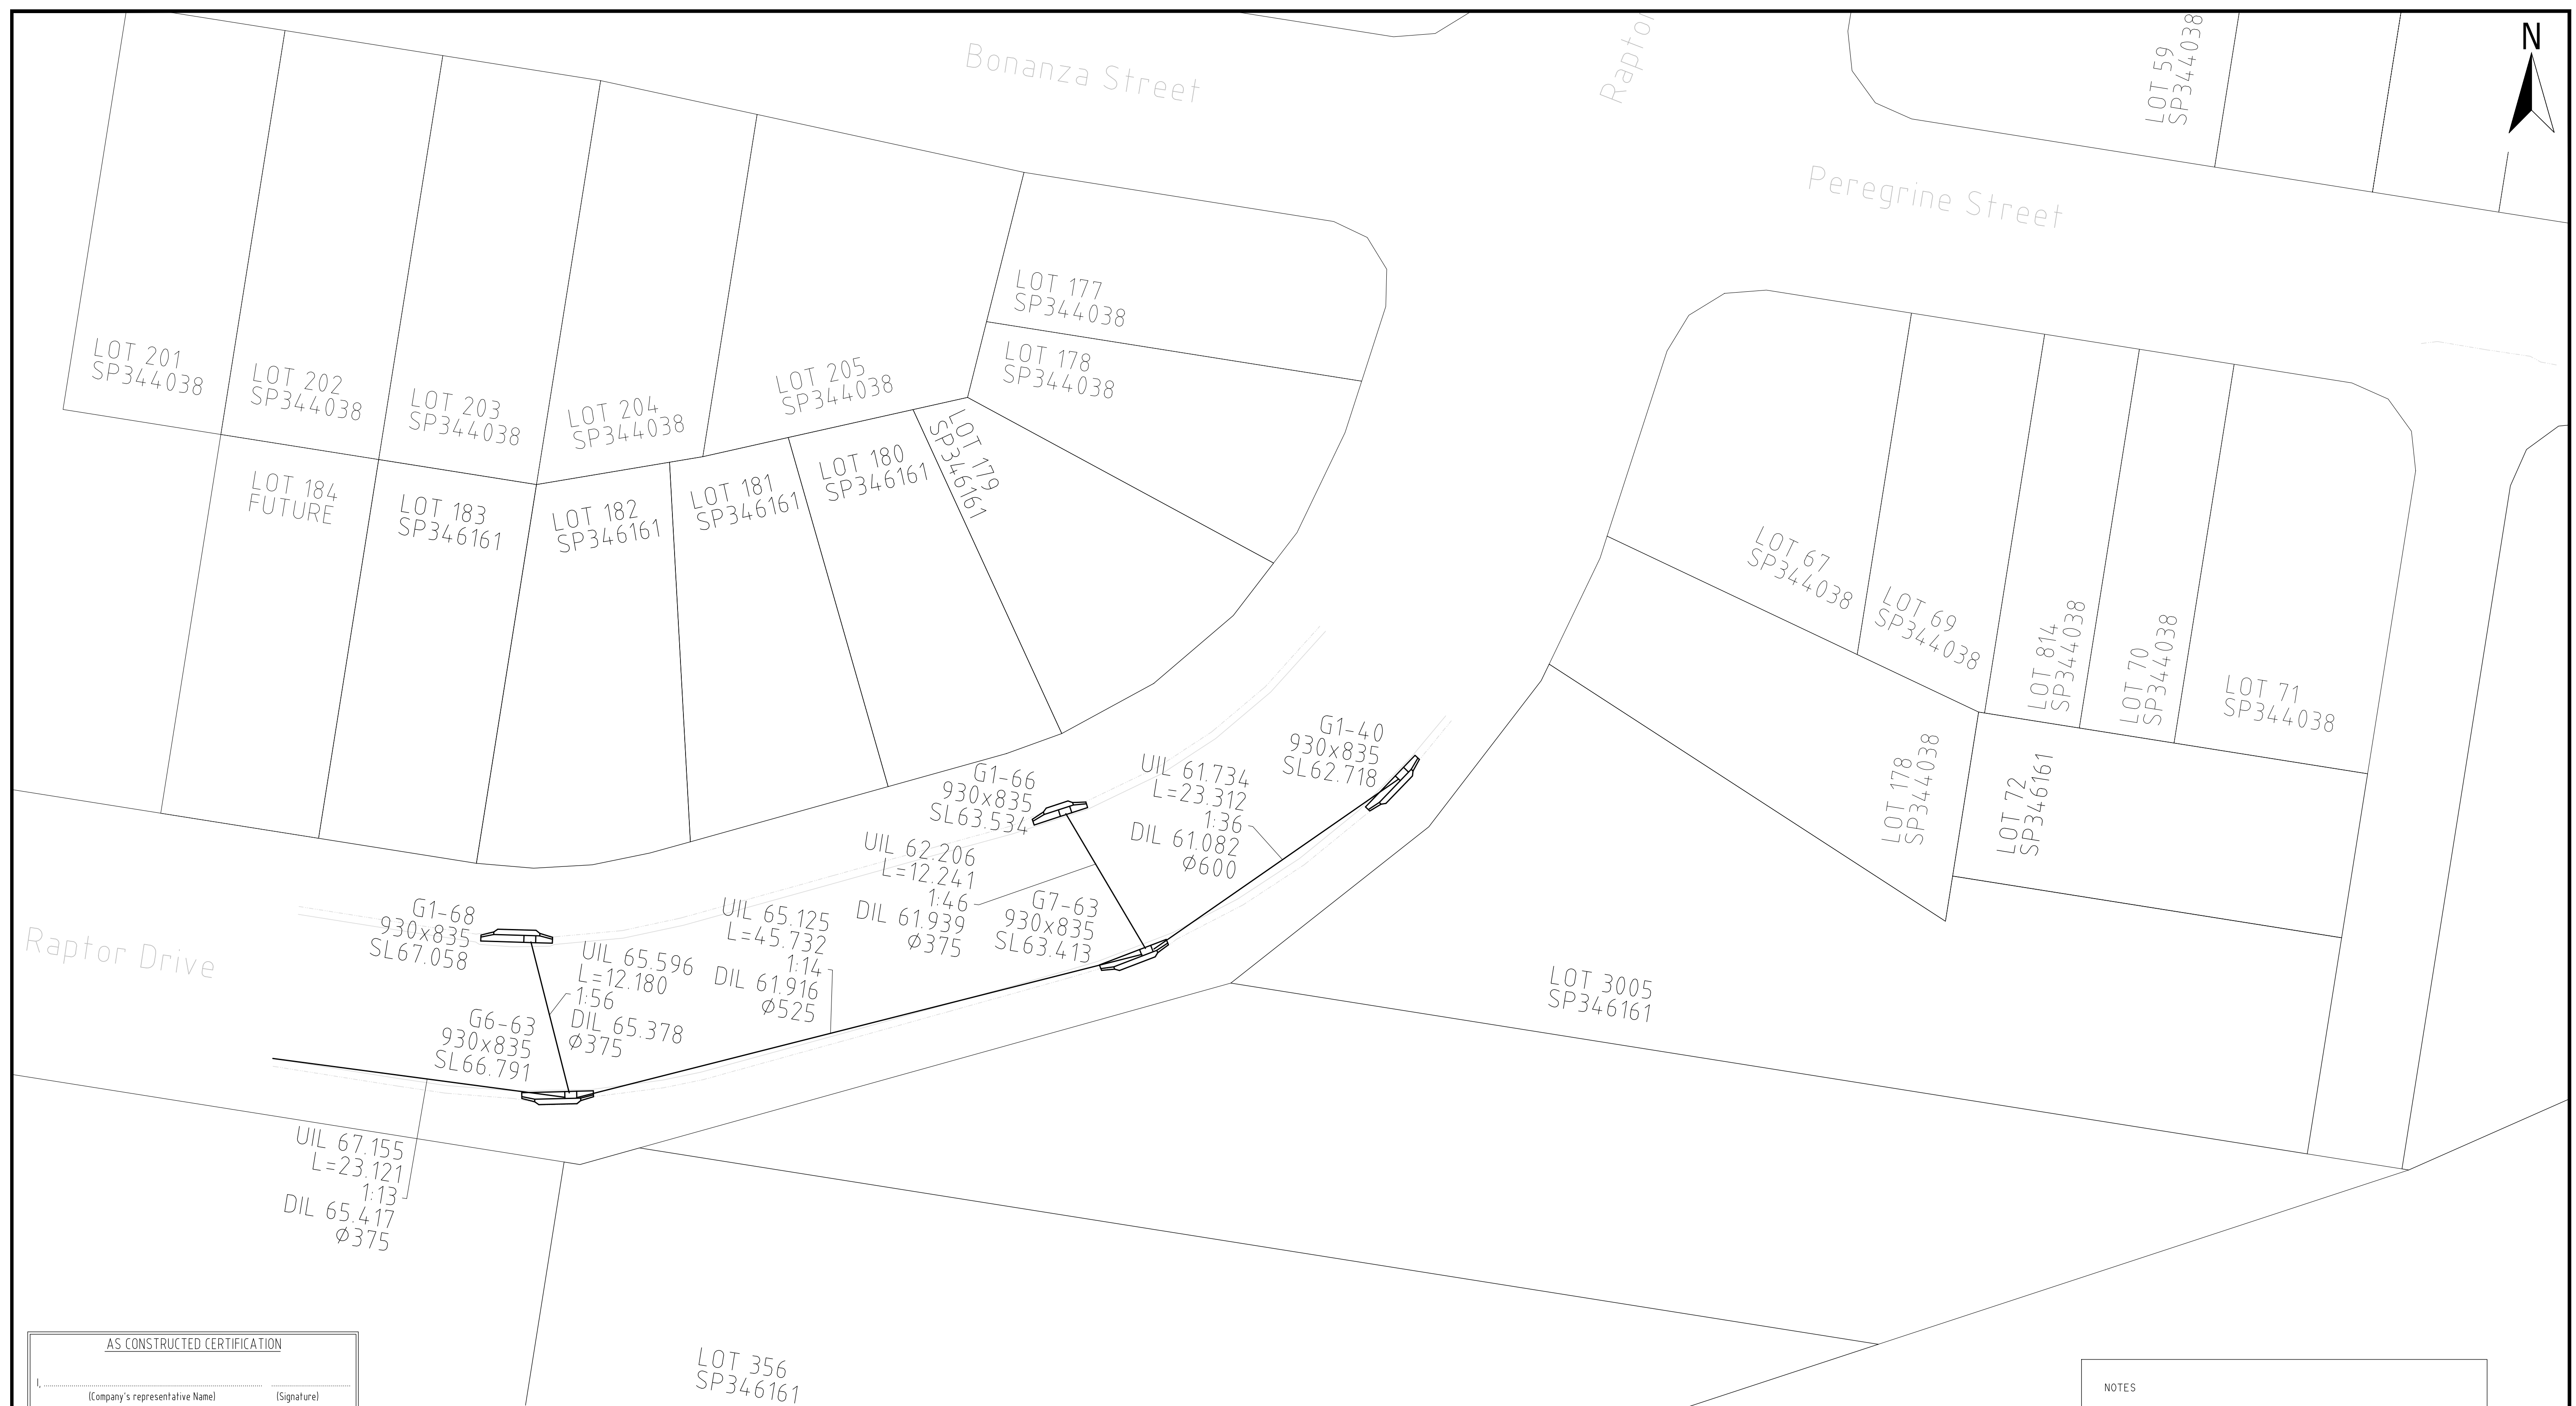

AS CONSTRUCTED CERTIFICATION

1. _____ (Company's representative Name) _____ (Signature)

(Date) _____ (RPEO)

Being a duly representative of: _____ (Company Name)

Hereby certify that

1. The information contained in this drawing / document is in compliance with approved drawings and design supplied under the Terms of the contract.
2. This represents an accurate "As constructed" record of works carried out and accept responsibility for the information contained in this drawing / document.

REGISTERED CADASTRAL SURVEYOR (QLD) CERTIFICATION


.....MNG QLD & NSW Pty Ltd..... hereby certify that the vertical and horizontal
locations and dimensions shown on this plan are a true and correct record and were
located by survey.

R. G. Andrew 4118 09/07/2026
Authorised Delegate Rego No. Date
MNG QLD & NSW Pty Ltd
Registered Qld Surveyor Corporation

NOTES

-ALL STORMWATER DRAINAGE PIPES ARE RCP CLASS '2' U.N.O.

AS CONSTRUCTED

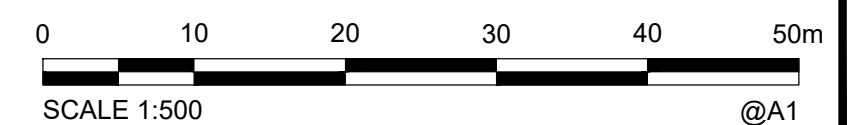

COORDINATE DATUM NOTE:

HORIZONTAL COORDINATES (E,N) SUPPLIED ARE MAPPING GRID OF AUSTRALIA (MGA), ZONE 56 BASED ON THE UNIVERSAL TRANSVERSE MERCATOR PROJECTION AND THE GEOCENTRIC DATUM OF AUSTRALIA 2020.

A1							
	1	09/07/2026	INITIAL ISSUE		MJK	RA	RA
	INDEX	DATE	REVISIONS		DRAWN	CHECKED	PASSED

DRAWN	MJK	09/07/2026
CHECKED	RA	09/07/2026
PASSED	RA	09/07/2026
	INITIALS	DATE



Perth | Brisbane | Melbourne | Sydney | Broome | South West WA



IPSWICH CITY COUNCIL

AMORY AT RIPLEY - STAGE 2A
AS-CONSTRUCTED STORMWATER

SCALE 1:250

SHEET 1 OF 1 SHEETS

DRAWING NO.

BRSS8354-02A-28-1