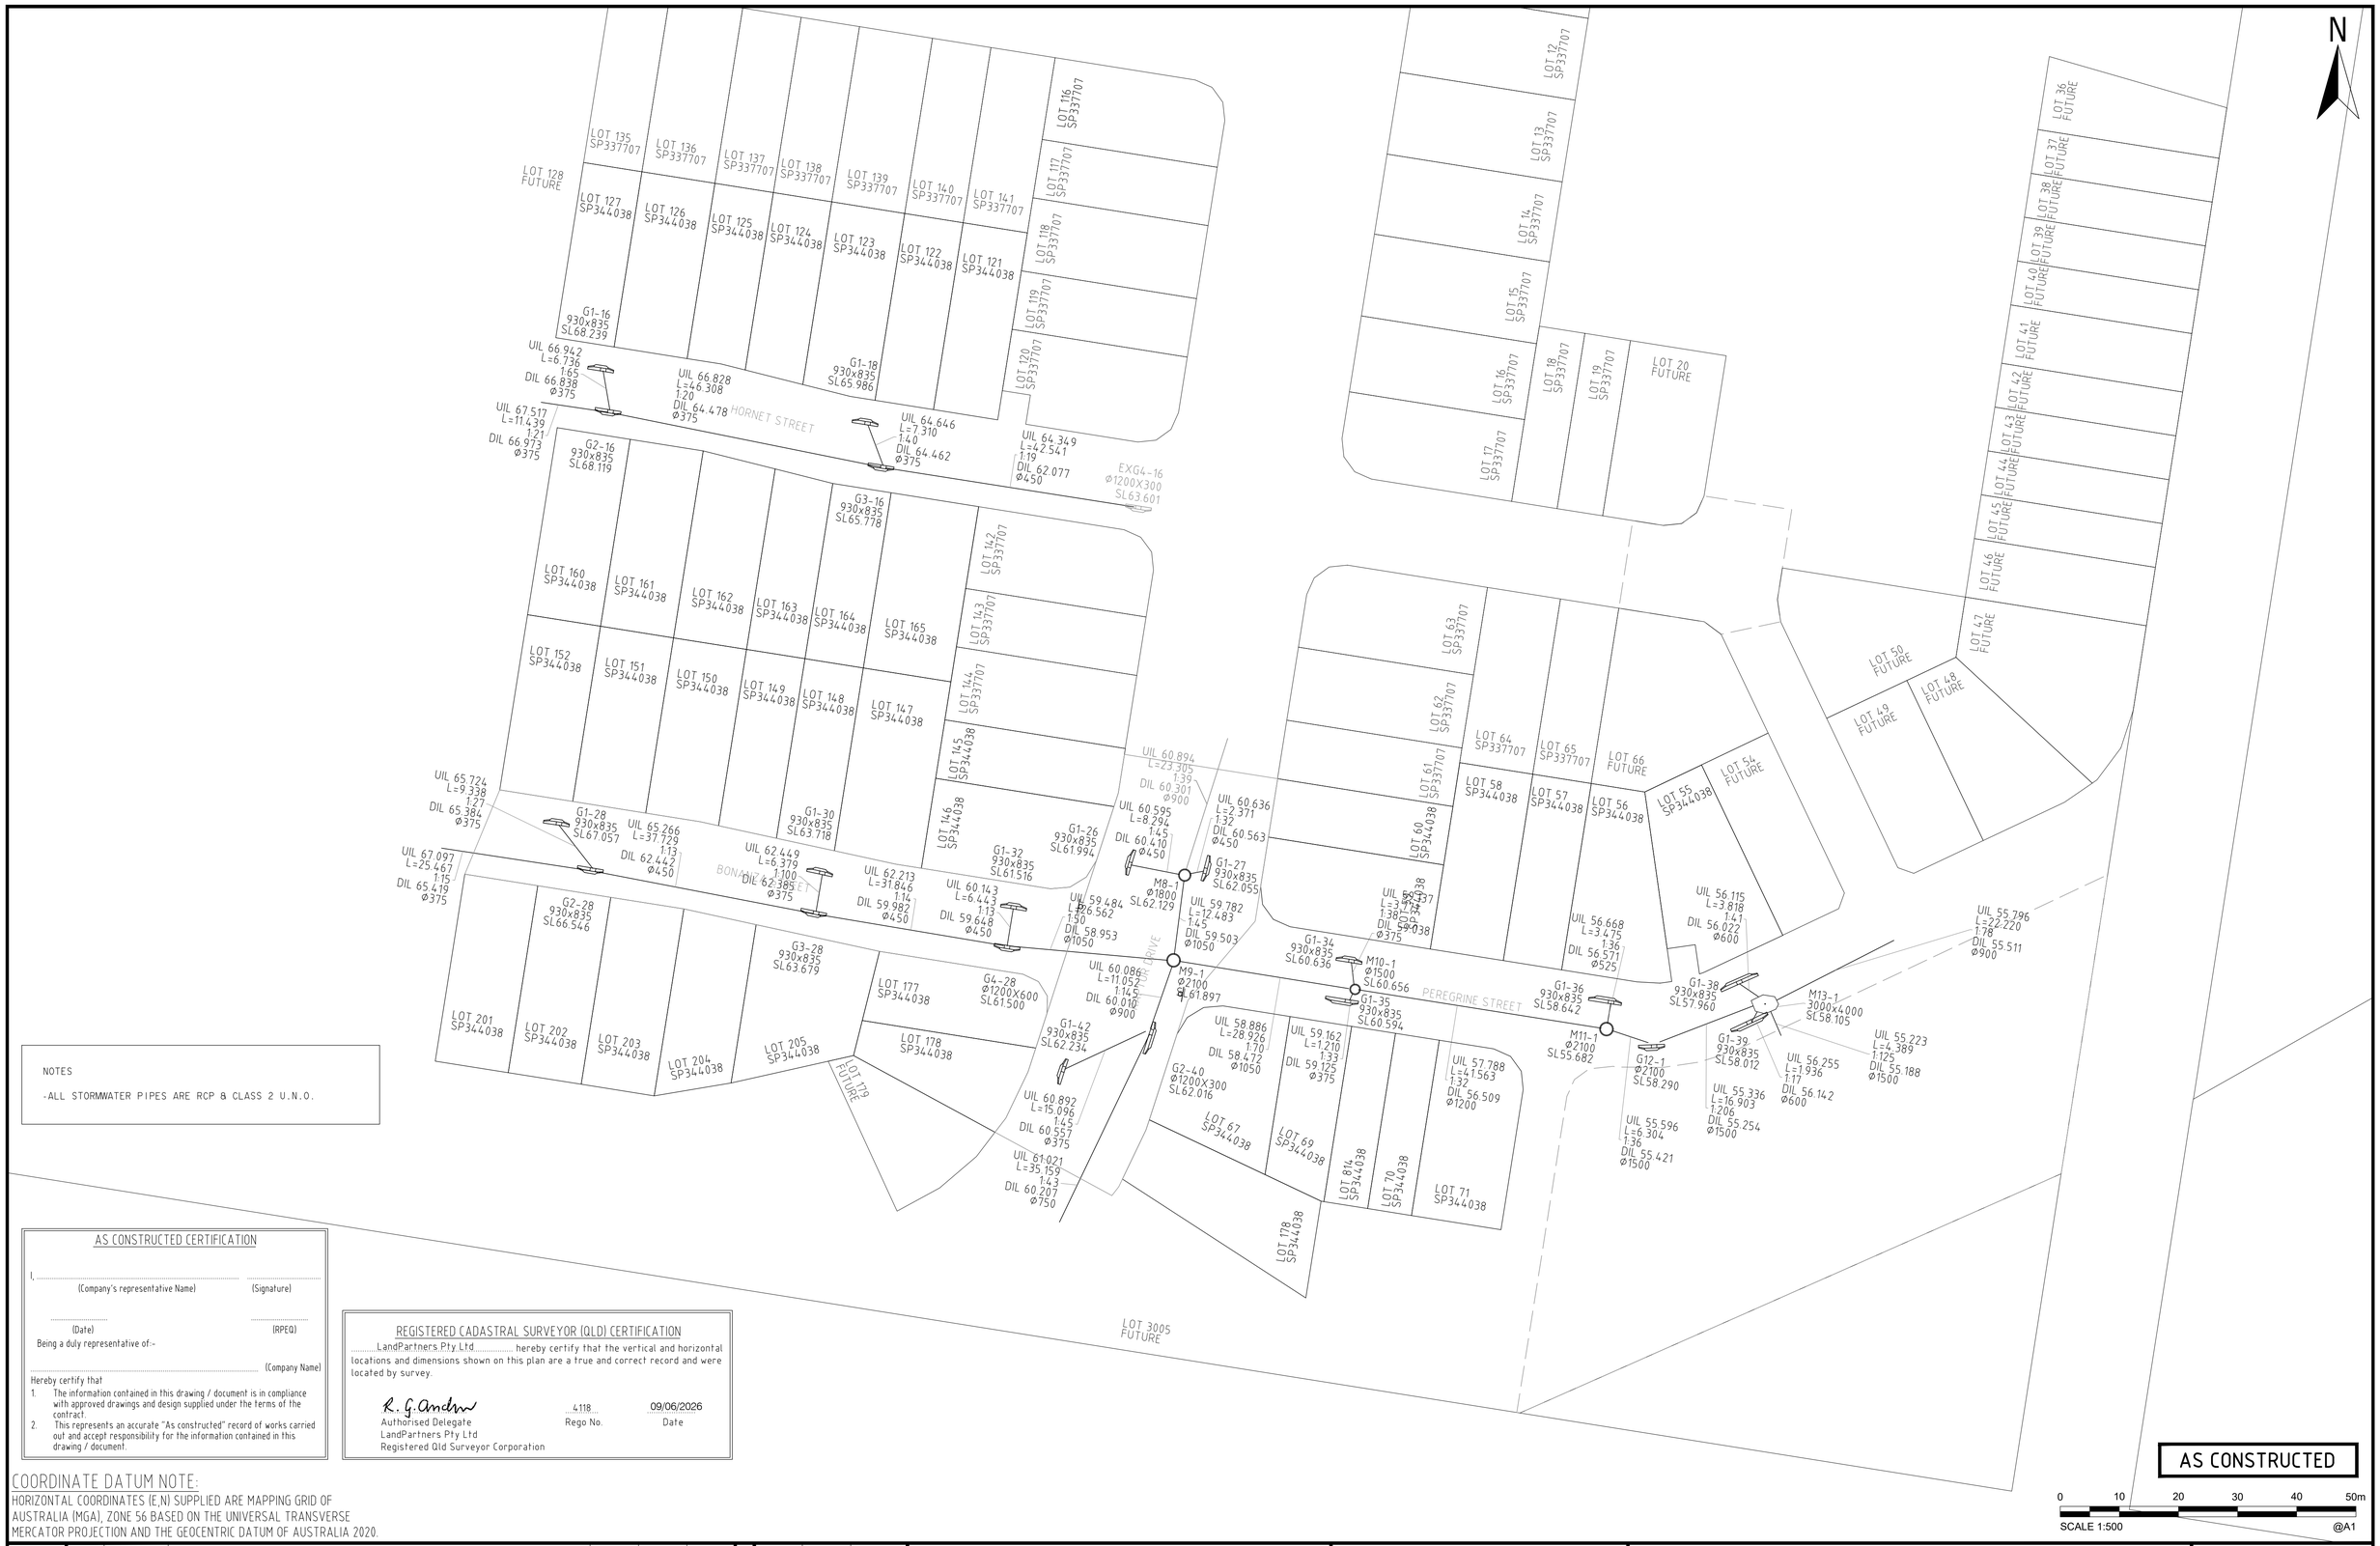

NOTES

-ALL STORMWATER PIPES ARE RCP & CLASS 2 U.N.O.

AS CONSTRUCTED CERTIFICATION

I, ... (Company's representative Name) ..... (Signature)

..... (Date) ..... (RPEQ)

Being a duly representative of:-

..... (Company Name)

Hereby certify that

1. The information contained in this drawing / document is in compliance with approved drawings and design supplied under the terms of the contract.
2. This represents an accurate "As constructed" record of works carried out and accept responsibility for the information contained in this drawing / document.

REGISTERED CADASTRAL SURVEYOR (QLD) CERTIFICATION

.....LandPartners Pty Ltd..... hereby certify that the vertical and horizontal locations and dimensions shown on this plan are a true and correct record and were located by survey.

R. G. Andrew	4118	09/06/2026
Authorised Delegate	Rego No.	Date
LandPartners Pty Ltd		
Registered Qld Surveyor Corporation		

COORDINATE DATUM NOTE:

HORIZONTAL COORDINATES (E,N) SUPPLIED ARE MAPPING GRID OF AUSTRALIA (MGA), ZONE 56 BASED ON THE UNIVERSAL TRANSVERSE MERCATOR PROJECTION AND THE GEOCENTRIC DATUM OF AUSTRALIA 2020.

A1

INDEX	DATE	REVISIONS	DRAWN	CHECKED	PASSED
1	09/06/2026	INITIAL ISSUE	V0	JV	RA

	INITIALS	DATE
DRAWN	V0	09/06/2026
CHECKED	JV	09/06/2026
PASSED	RA	09/06/2026

MNG LANDPARTNERS
Brisbane Office
Level 1
18 Little Cribb Street
Milton QLD 4064
p: (07) 3842 1000
e: brisbane@mnglandpartners.com.au
w: www.landpartners.com.au
Perth | Brisbane | Melbourne | Sydney | Broome | South West WA

City of Ipswich

IPSWICH CITY COUNCIL

AMORY AT RIPLEY STAGE 1B
RIPLEY ESTATE DEVELOPMENT PTY LTD
AS-CONSTRUCTED STORMWATER

SCALE 1:500
SHEET 1 OF 1 SHEETS
DRAWING NO.
BRSS8354-01B-60-1