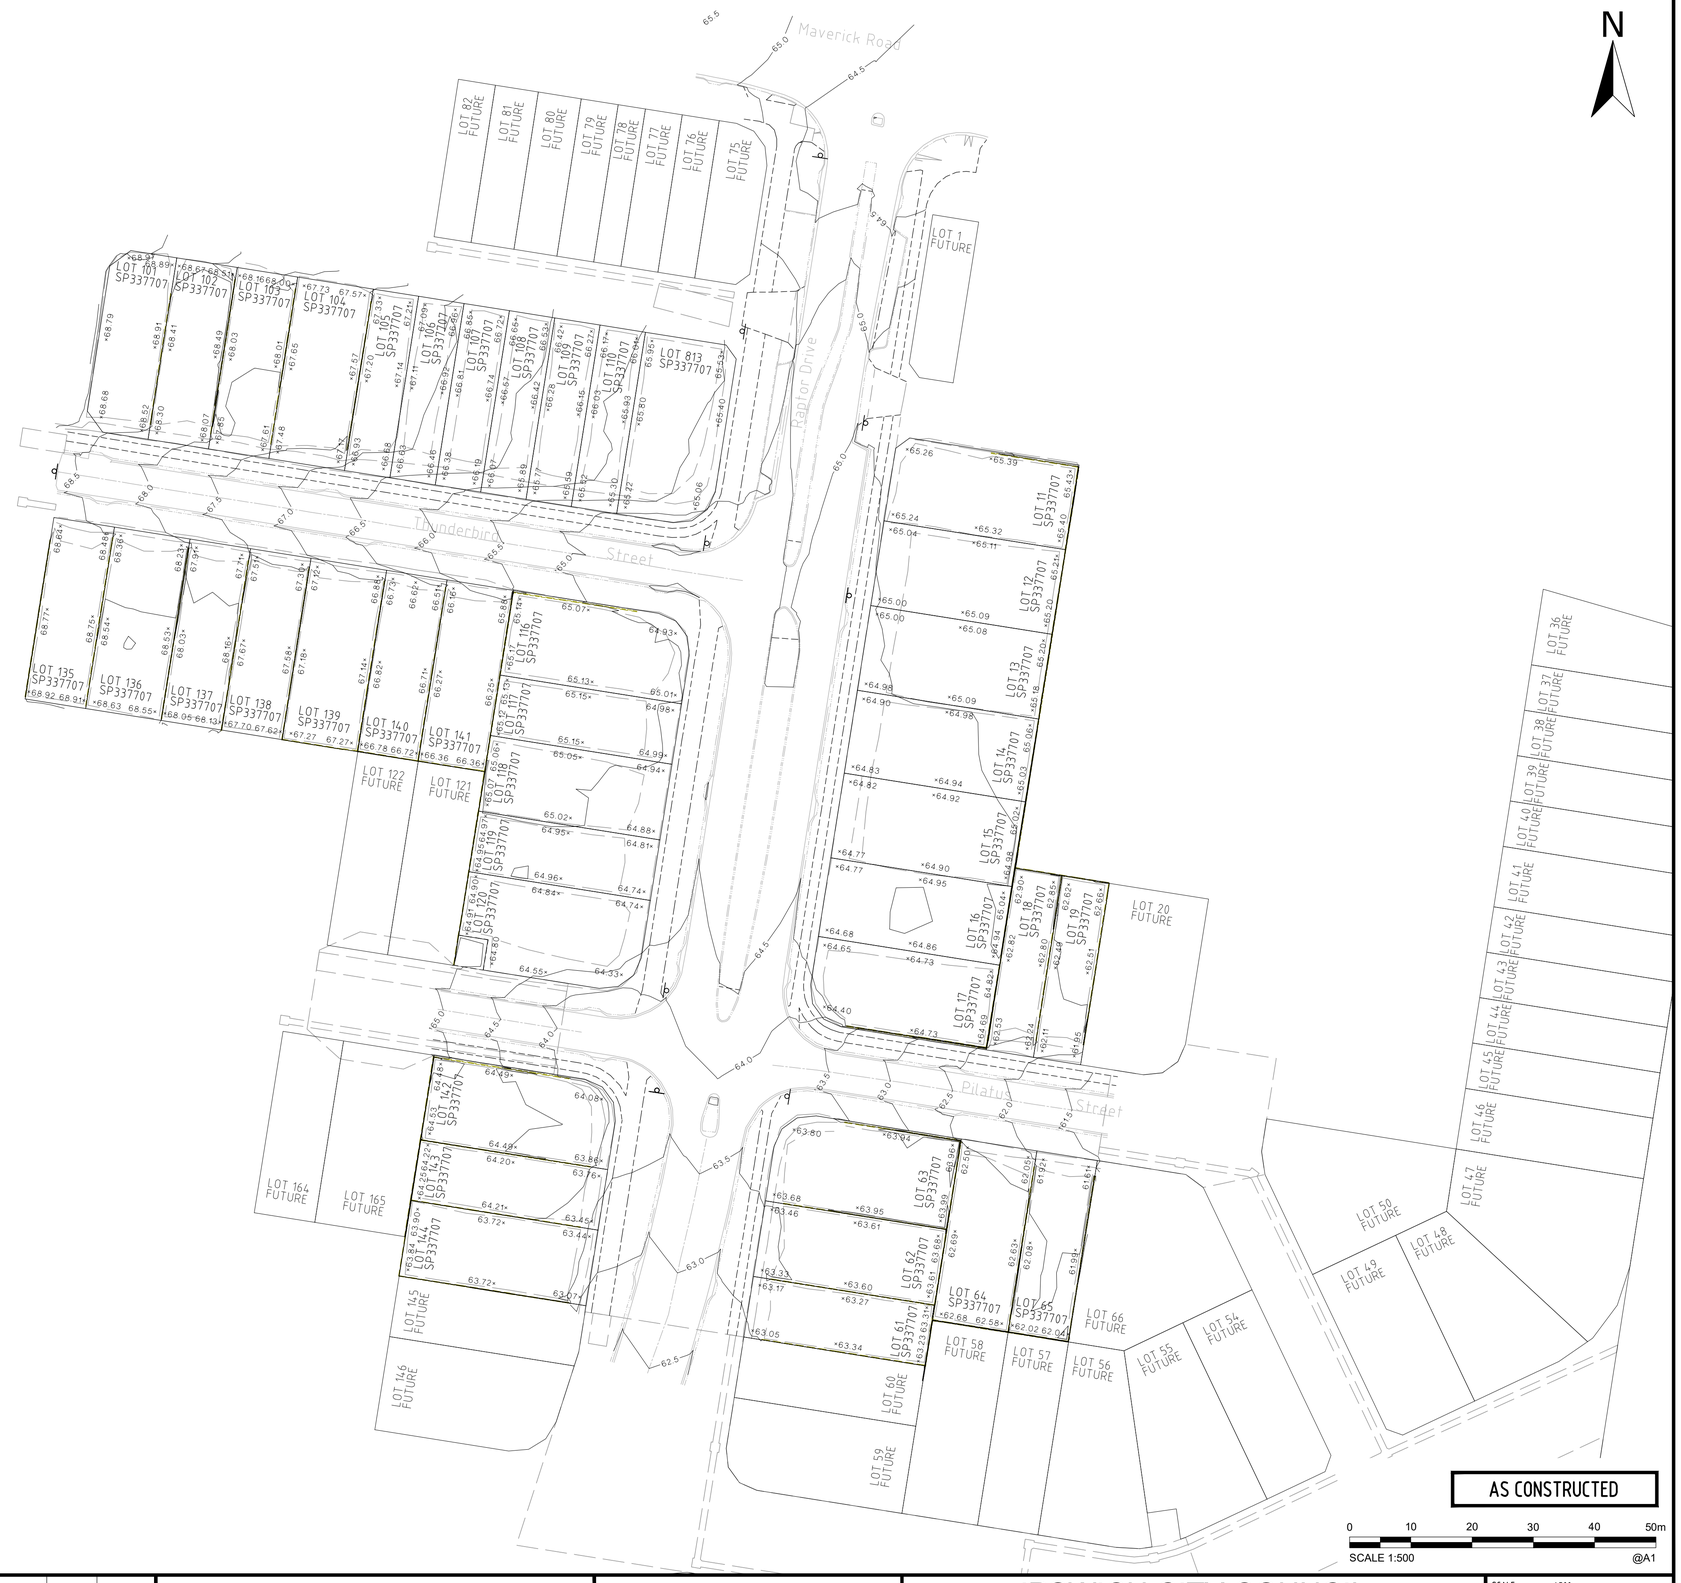

LEGEND

- BOTTOM OF WALL
- TOP OF WALL
- LIP OF KERB
- BACK OF KERB
- EDGE OF CONCRETE
- EDGE OF ROCK
- CONTOURS
- CHANGE OF GRADE
- BOTTOM OF BANK
- TOP OF BANK
- CROWN OF ROAD
- FENCE
- SIGN

AS CONSTRUCTED CERTIFICATION

I, ...
(Company's representative Name) (Signature)

....
(Date) (RPEQ)

Being a duly representative of:-

..... (Company Name)

Hereby certify that

1. The information contained in this drawing / document is in compliance with approved drawings and design supplied under the terms of the contract.
2. This represents an accurate "As constructed" record of works carried out and accept responsibility for the information contained in this drawing / document.

REGISTERED CADASTRAL SURVEYOR (QLD) CERTIFICATION

.....LandPartners Pty Ltd..... hereby certify that the vertical and horizontal locations and dimensions shown on this plan are a true and correct record and were located by survey.

R. G. Anderson — Authorised Delegate, LandPartners Pty Ltd, Registered Qld Surveyor Corporation
4118 — Rego No.
20/05/2026 — Date

COORDINATE DATUM NOTE:

HORIZONTAL COORDINATES (E,N) SUPPLIED ARE MAPPING GRID OF AUSTRALIA (MGA), ZONE 56 BASED ON THE UNIVERSAL TRANSVERSE MERCATOR PROJECTION AND THE GEOCENTRIC DATUM OF AUSTRALIA 2020.

A1

INDEX	DATE	REVISIONS	DRAWN	CHECKED	PASSED
1	20/05/2026	INITIAL ISSUE	BB	VO	JV

	INITIALS	DATE
DRAWN	BB	20/05/2026
CHECKED	VO	20/05/2026
PASSED	JV	20/05/2026

MNG LANDPARTNERS
Brisbane Office
Level 1
18 Little Cribb Street
Milton QLD 4064
p: (07) 3842 1000
e: brisbane@mnglandpartners.com.au
w: www.landpartners.com.au
Perth | Brisbane | Melbourne | Sydney | Broome | South West WA

City of Ipswich

IPSWICH CITY COUNCIL

AMORY AT RIPLEY STAGE 1A
RIPLEY ESTATE DEVELOPMENT PTY LTD
AS CONSTRUCTED TOPOGRAPHY

SCALE 1:500
SHEET 1 OF 1 SHEETS
DRAWING NO.
BRSS8354-01A-67-1