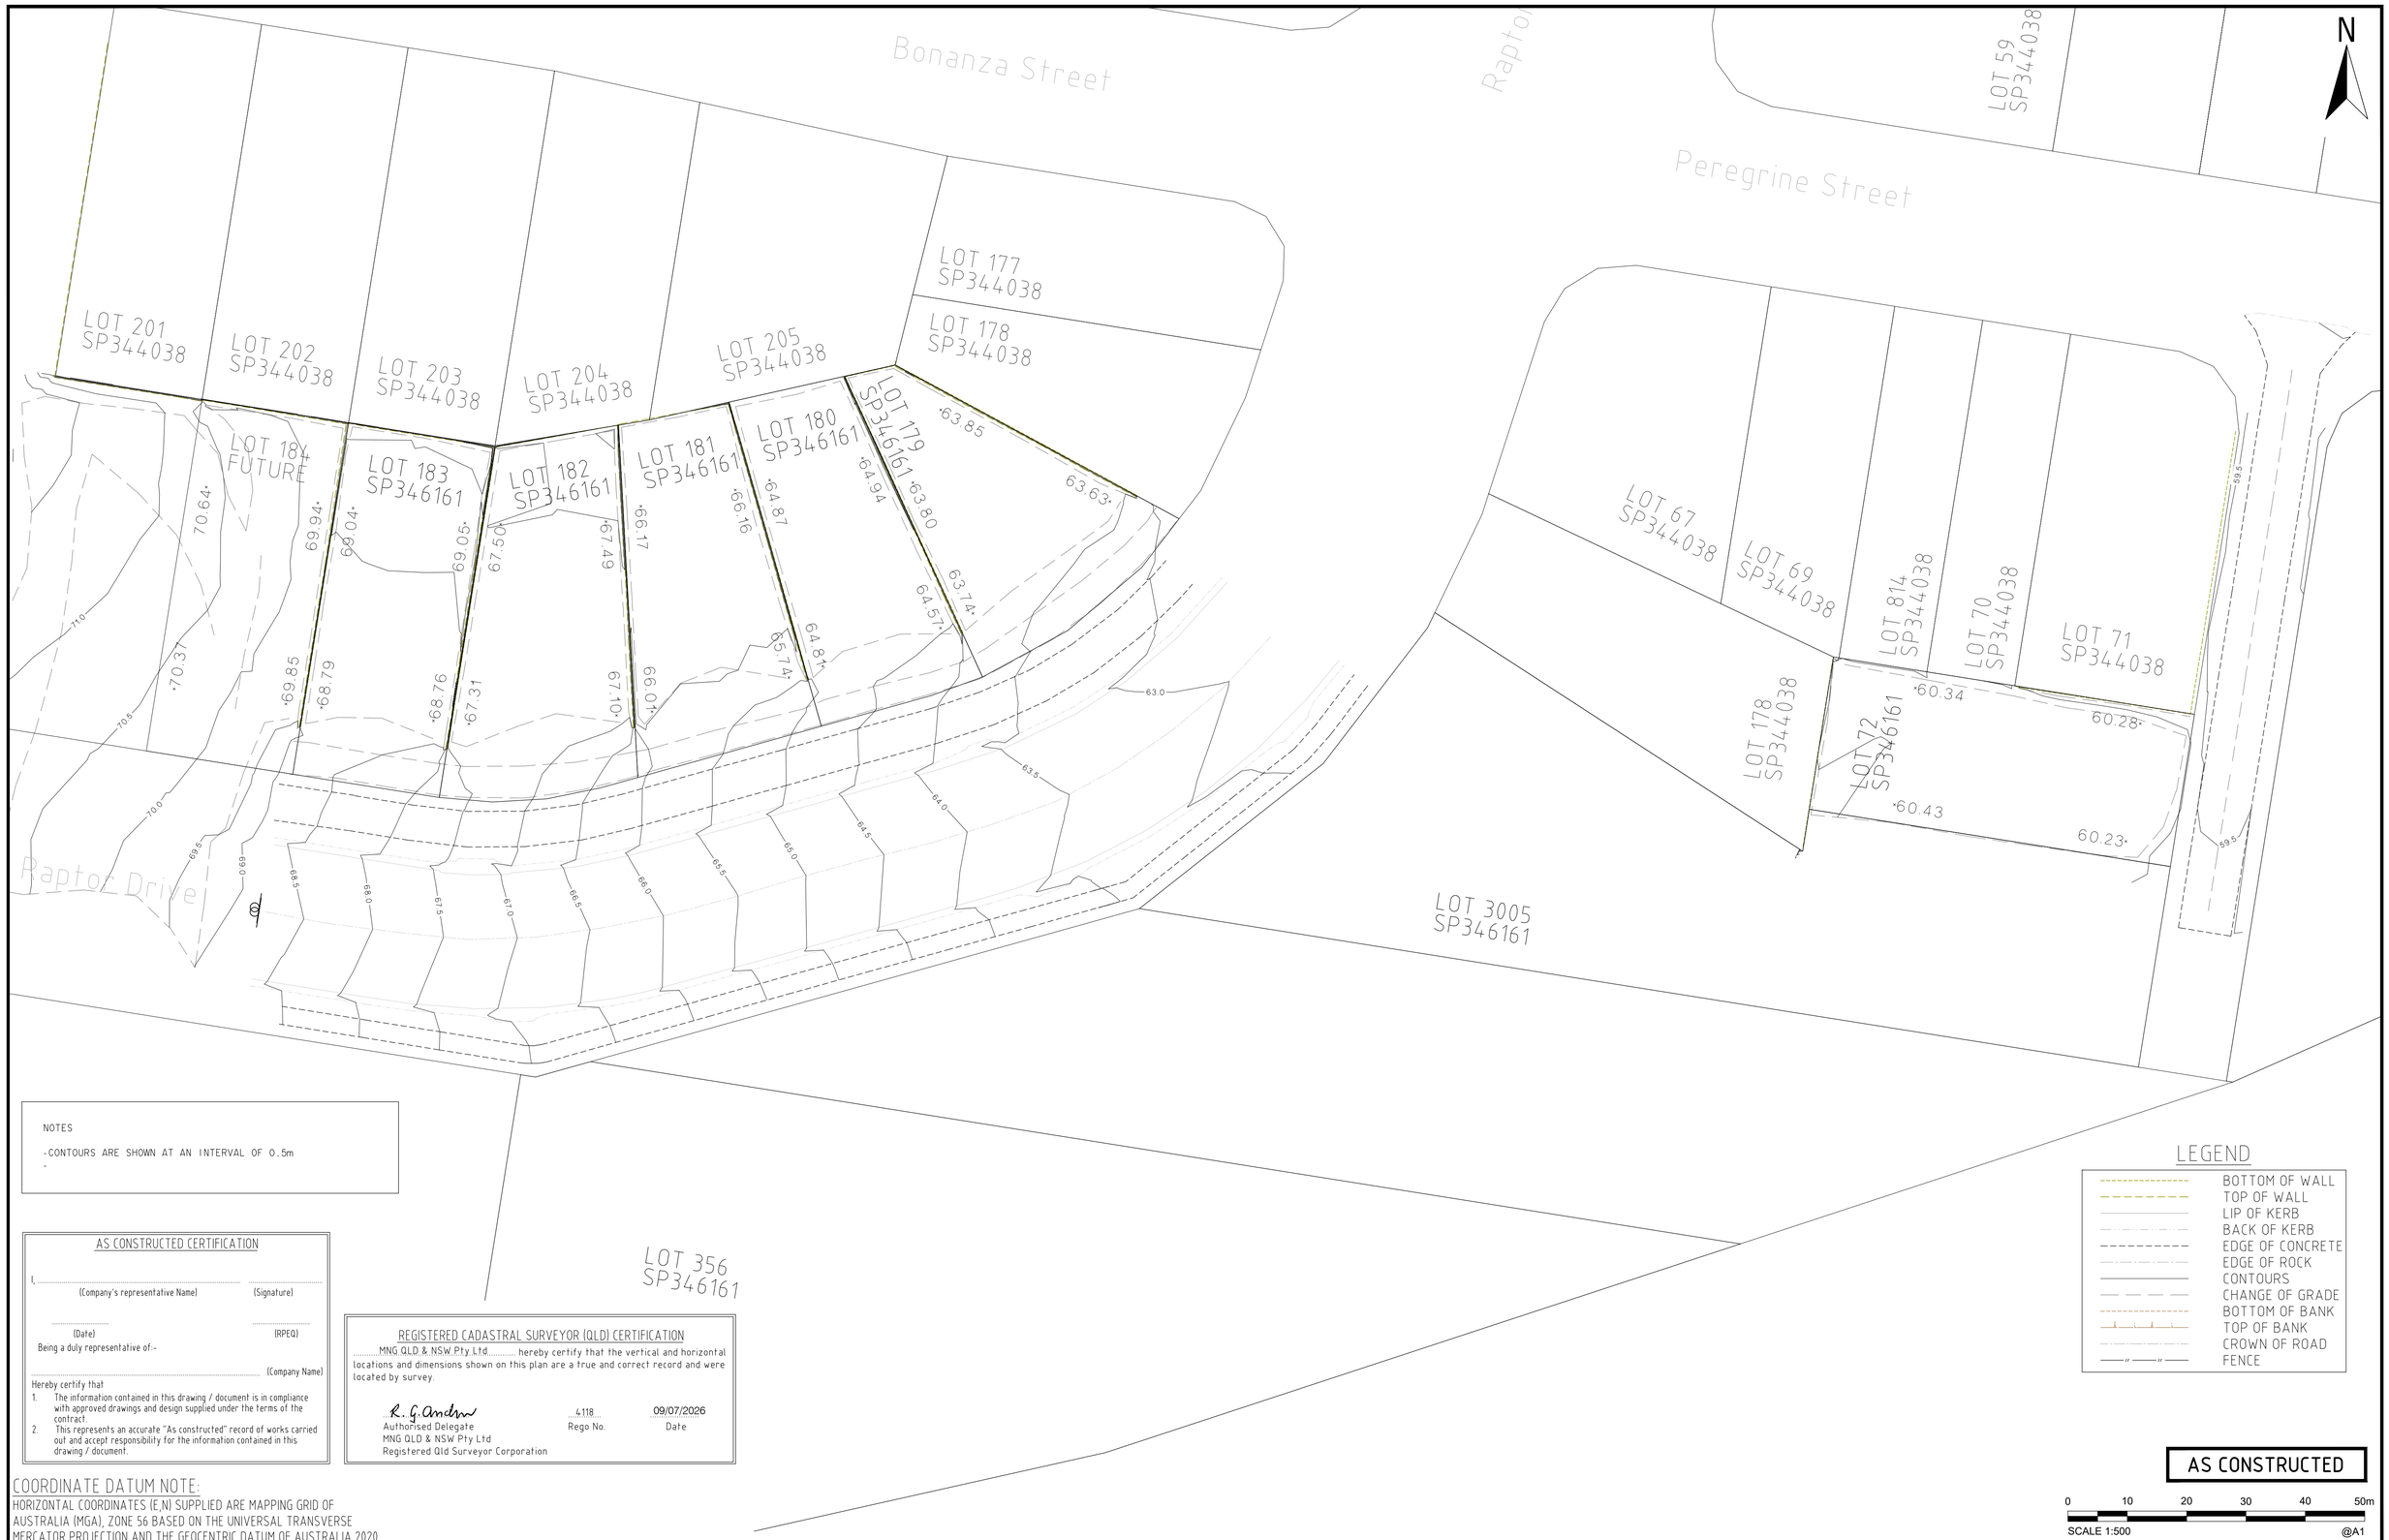

NOTES

- CONTOURS ARE SHOWN AT AN INTERVAL OF 0.5m
-

AS CONSTRUCTED CERTIFICATION

I, ... (Company's representative Name) ..... (Signature)

..... (Date) ..... (RPEQ)

Being a duly representative of:-

..... (Company Name)

Hereby certify that

1. The information contained in this drawing / document is in compliance with approved drawings and design supplied under the terms of the contract.
2. This represents an accurate "As constructed" record of works carried out and accept responsibility for the information contained in this drawing / document.

REGISTERED CADASTRAL SURVEYOR (QLD) CERTIFICATION

.....MNG QLD & NSW Pty Ltd..... hereby certify that the vertical and horizontal locations and dimensions shown on this plan are a true and correct record and were located by survey.

R. G. Andrew — Authorised Delegate, MNG QLD & NSW Pty Ltd, Registered Qld Surveyor Corporation

...4118... Rego No.

09/07/2026 Date

LEGEND

- BOTTOM OF WALL
- TOP OF WALL
- LIP OF KERB
- BACK OF KERB
- EDGE OF CONCRETE
- EDGE OF ROCK
- CONTOURS
- CHANGE OF GRADE
- BOTTOM OF BANK
- TOP OF BANK
- CROWN OF ROAD
- FENCE

AS CONSTRUCTED

0 10 20 30 40 50m

SCALE 1:500 @A1

COORDINATE DATUM NOTE:

HORIZONTAL COORDINATES (E,N) SUPPLIED ARE MAPPING GRID OF AUSTRALIA (MGA), ZONE 56 BASED ON THE UNIVERSAL TRANSVERSE MERCATOR PROJECTION AND THE GEOCENTRIC DATUM OF AUSTRALIA 2020.

A1

INDEX	DATE	REVISIONS	DRAWN	CHECKED	PASSED
1	09/07/2026	INITIAL ISSUE	MJK	RA	RA

	INITIALS	DATE
DRAWN	MJK	09/07/2026
CHECKED	RA	09/07/2026
PASSED	RA	09/07/2026

MNG
Brisbane Office
Level 3
108 Wickham Street
Fortitude Valley QLD 4006
p: (07) 3842 1000
e: brisbane@mngsurvey.com.au
w: mngsurvey.com.au
Perth | Brisbane | Melbourne | Sydney | Broome | South West WA

City of Ipswich

IPSWICH CITY COUNCIL

AMORY AT RIPLEY - STAGE 2A
AS-CONSTRUCTED TOPOGRAPHY

SCALE 1:250
SHEET 1 OF 1 SHEETS
DRAWING NO.
BRSS8354-02A-29-1