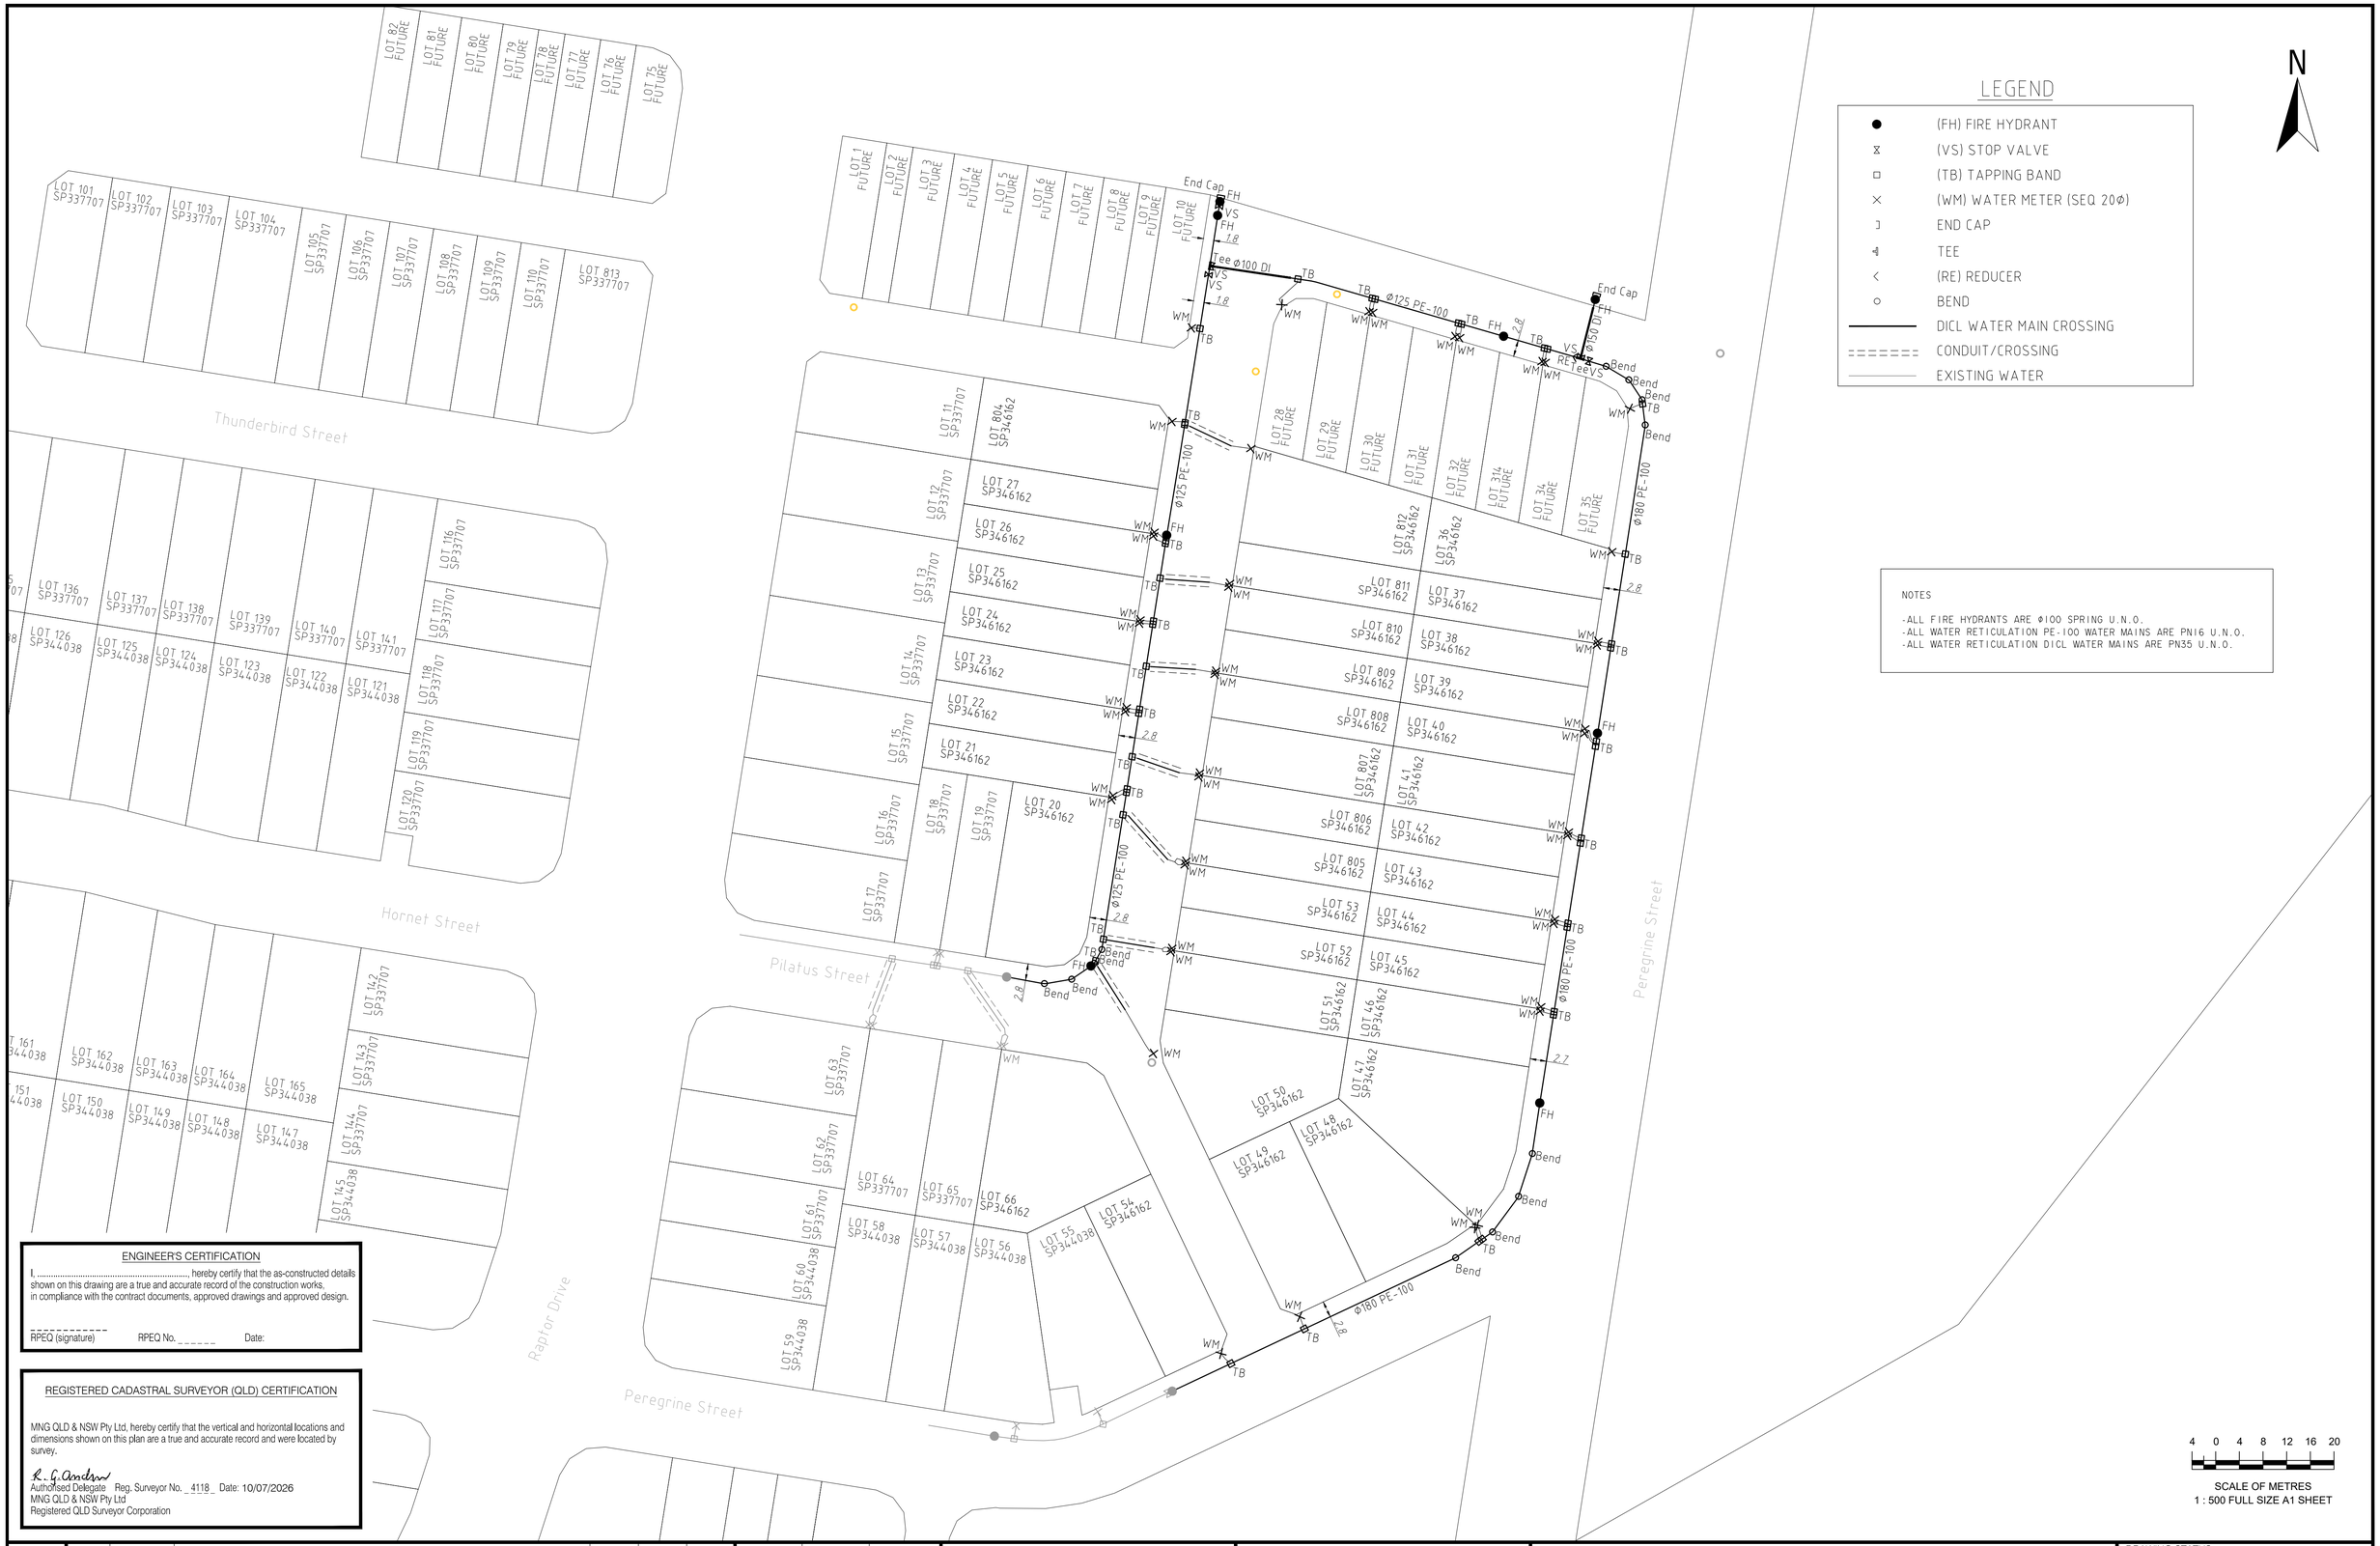

ENGINEER'S CERTIFICATION

I, ..., hereby certify that the as-constructed details shown on this drawing are a true and accurate record of the construction works, in compliance with the contract documents, approved drawings and approved design.

RPEQ (signature) RPEQ No. _____ Date:

REGISTERED CADASTRAL SURVEYOR (QLD) CERTIFICATION

MNG QLD & NSW Pty Ltd, hereby certify that the vertical and horizontal locations and dimensions shown on this plan are a true and accurate record and were located by survey.

R. G. Andrew
Authorised Delegate Reg. Surveyor No. 4118 Date: 10/07/2026
MNG QLD & NSW Pty Ltd
Registered QLD Surveyor Corporation

REV NO	DATE	REVISION PURPOSE / DESCRIPTION	DRAWN	RPEQ	RPEQ No
1	10/07/2026	INITIAL ISSUE	MJK		

	INITIALS	DATE
DRAWN	MJK	10/07/2026
CHECKED	RA	10/07/2026
APPROVED	RA	10/07/2026

MNG
Brisbane Office
Level 3
108 Wickham Street
Fortitude Valley QLD 4006
p: (07) 3842 1000
e: brisbane@mngsurvey.com.au
w: mngsurvey.com.au
Perth | Brisbane | Melbourne | Sydney | Broome | South West WA

RIPLEY ESTATE DEVELOPMENT PTY LTD

AMORY AT RIPLEY
STAGE 2B

AS-CONSTRUCTED
WATER

DRAWING STATUS
AS CONSTRUCTED

SHEET 1 OF 1 SHEETS

DRAWING NO. BRSS8354-02B-52-1

REV. 1

A1